


T. 21S. R. 3W. W.M.

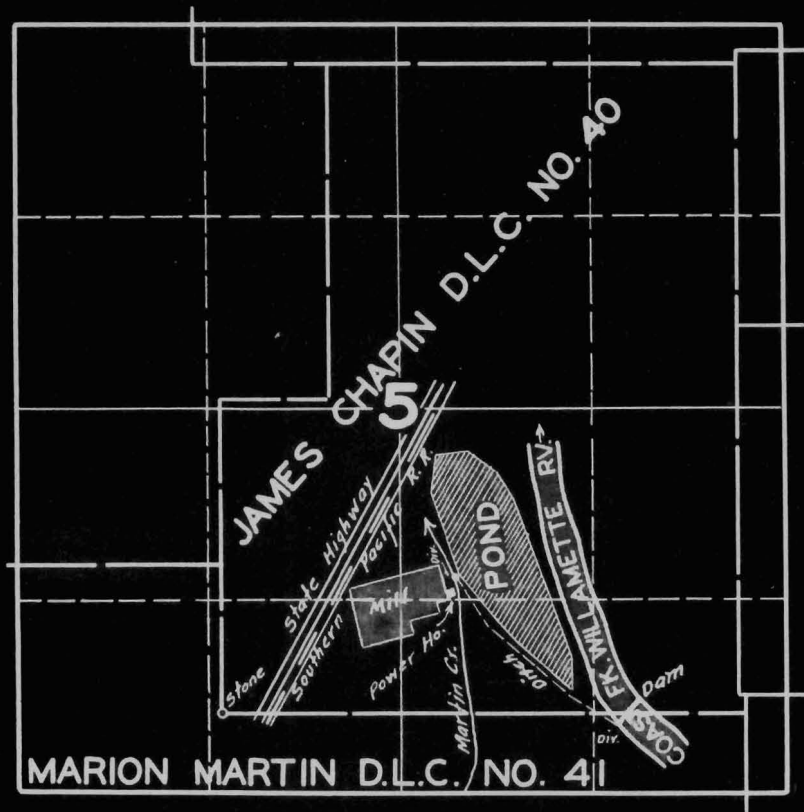

FINAL PROOF SURVEY

UNDER

R-18789

R-751

Application No. 18788 Permit No. 14430

IN NAME OF

W.A. WOODARD LUMBER COMPANY

Surveyed JULY 24 1946, by