


T.28S.R.12W.W.M.

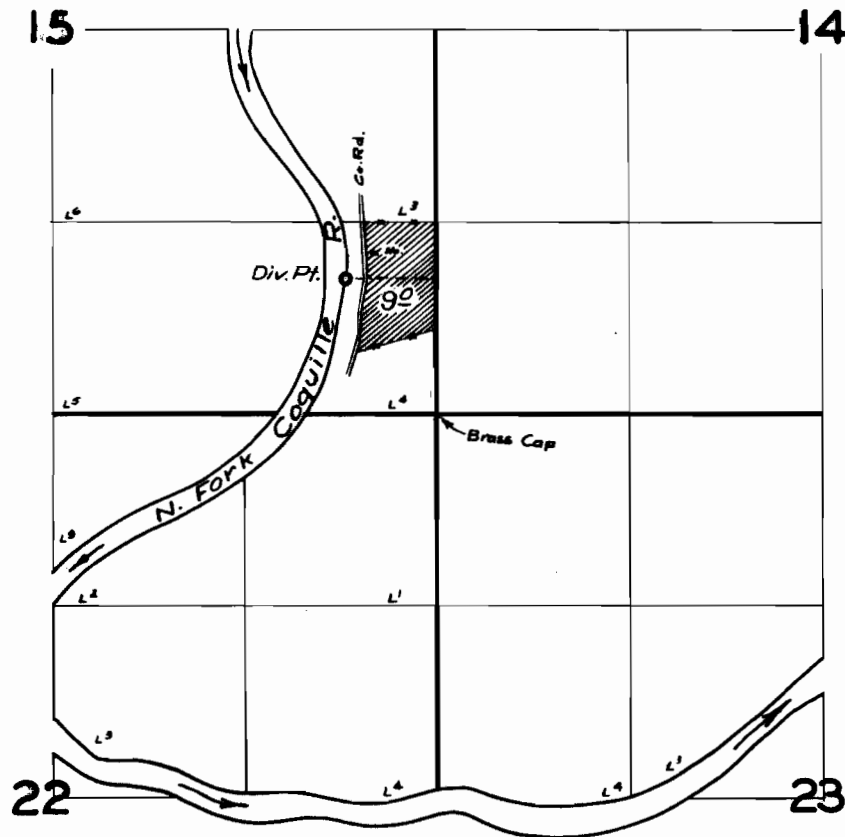

**FINAL PROOF SURVEY**  
UNDER

Application No. *21710* Permit No. *17098*  
IN NAME OF

*Homer White*

Surveyed *26 May 1958*, by *Tr. Bish*