


T.28S.R.14 W.W.M.

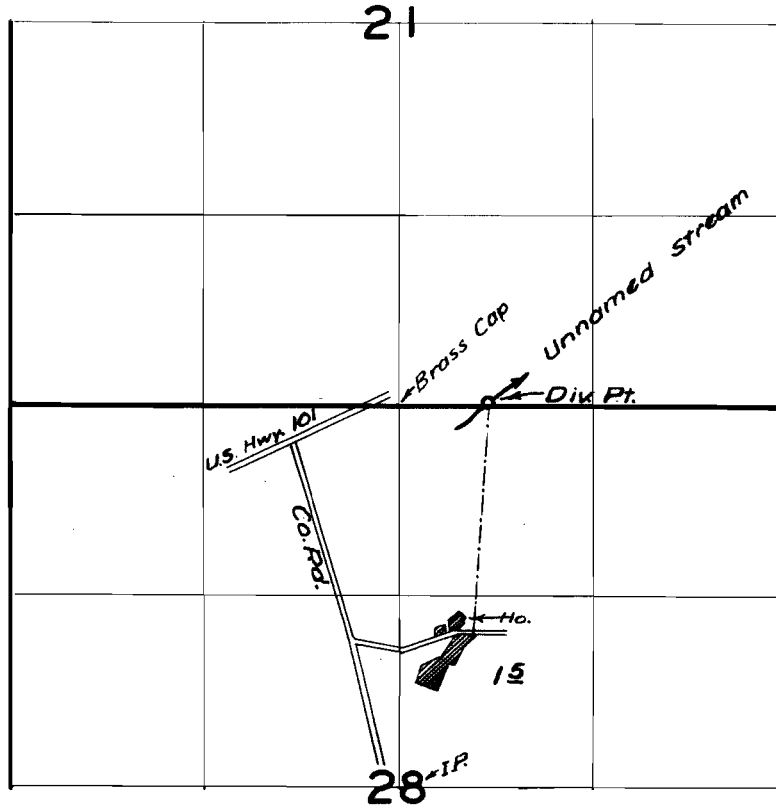

FINAL PROOF SURVEY UNDER

Application No. 21771 Permit No. 17127
IN NAME OF

John M. Conrad

Surveyed 23 April 1958, by M. B. Bick