


T.29 S.R.15 W.W.M.

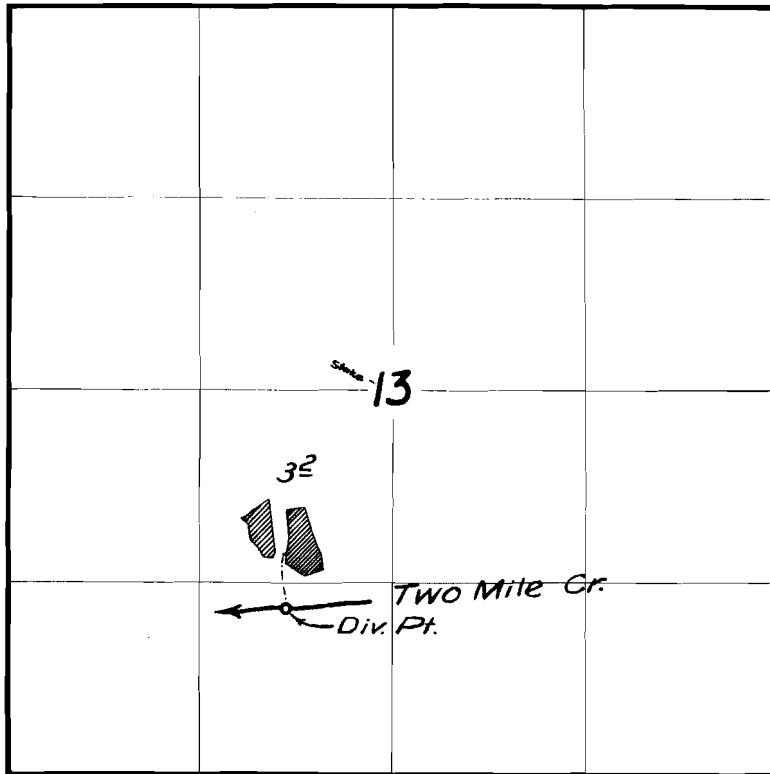

**FINAL PROOF SURVEY**  
UNDER

Application No. 22219 Permit No. 17494  
IN NAME OF

Melvin Boak

Surveyed 23 April 1958, by Tom Bish