


T. 4 S. R. 5 W. W. M.

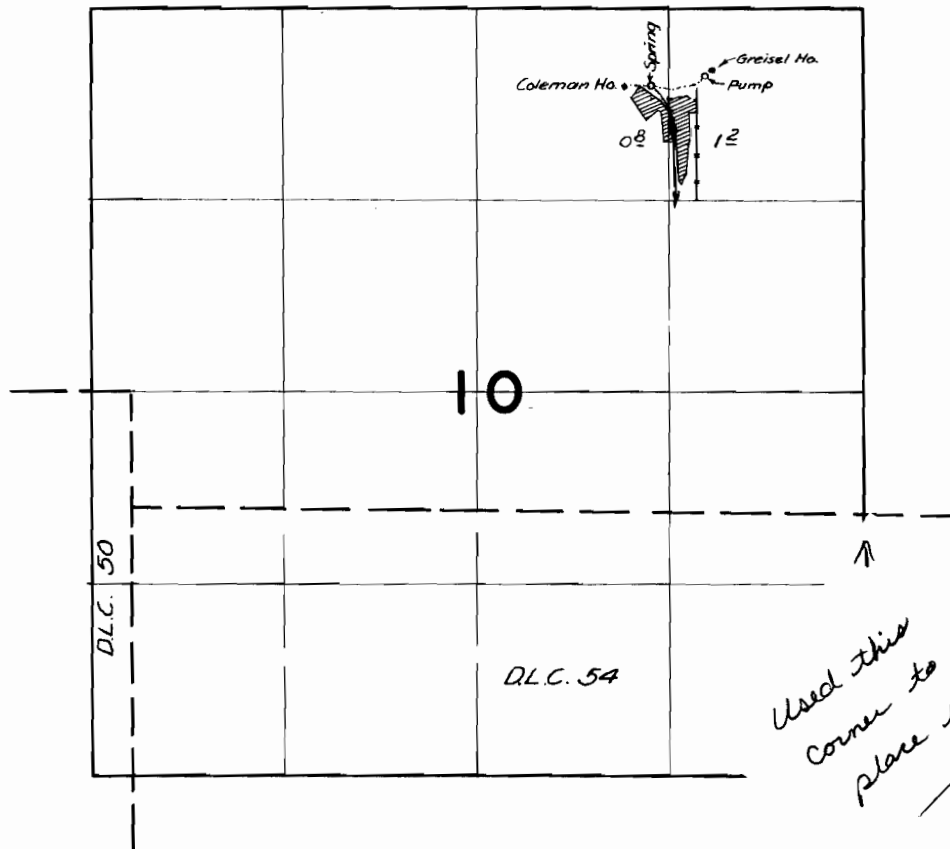

FINAL PROOF SURVEY
UNDER

Application No. 22817 Permit No. 18039
IN NAME OF

Vernon E. Coleman

Surveyed May 13 1957, by M. Bish