


T.34 S.R.14 W.W.M.

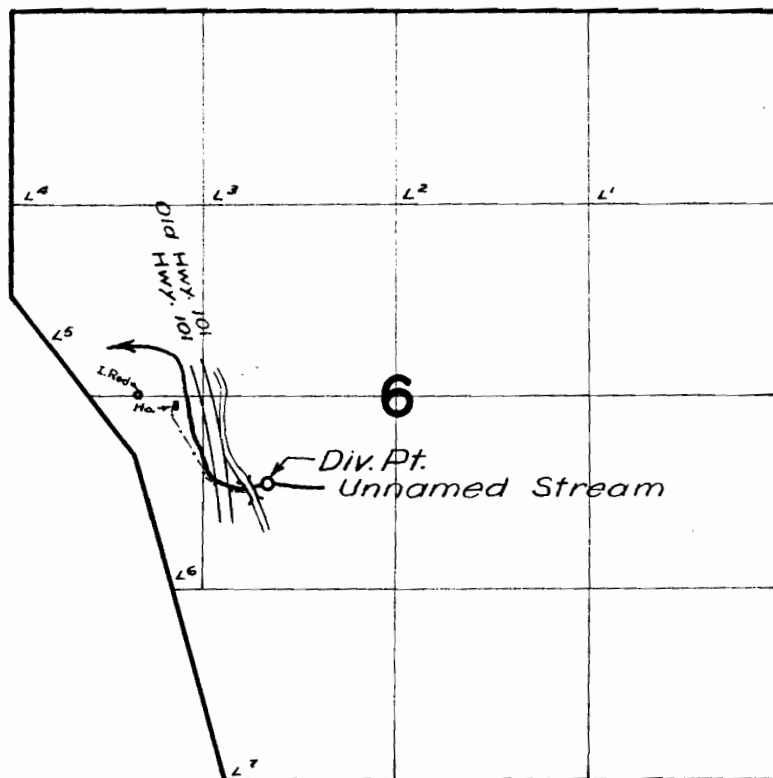

FINAL PROOF SURVEY
UNDER

Application No. 23551 Permit No. 18639
IN NAME OF

Mrs. Vera H. Fedenbaugh

Surveyed 15 April 1958, by M. Bush