


T. 2S R. 4E. W.M.

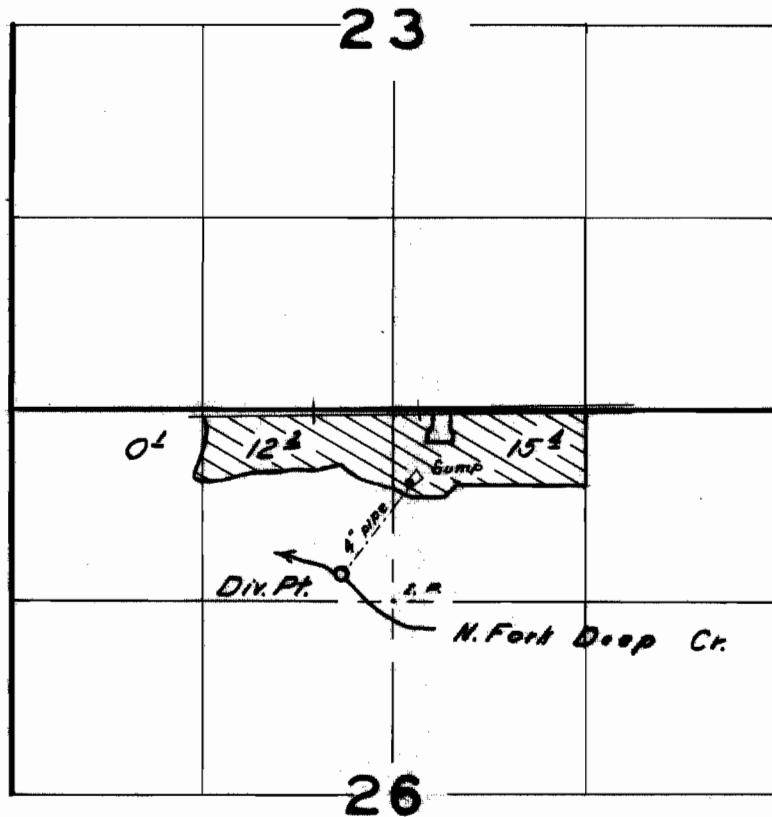

**FINAL PROOF SURVEY**  
UNDER

Application No. 22681 Permit No. 18678  
IN NAME OF

J. A. Von Bergen

Surveyed June 24, 25 1958, by W. N. Perry