


T. 2S. R. 5E. W.M.

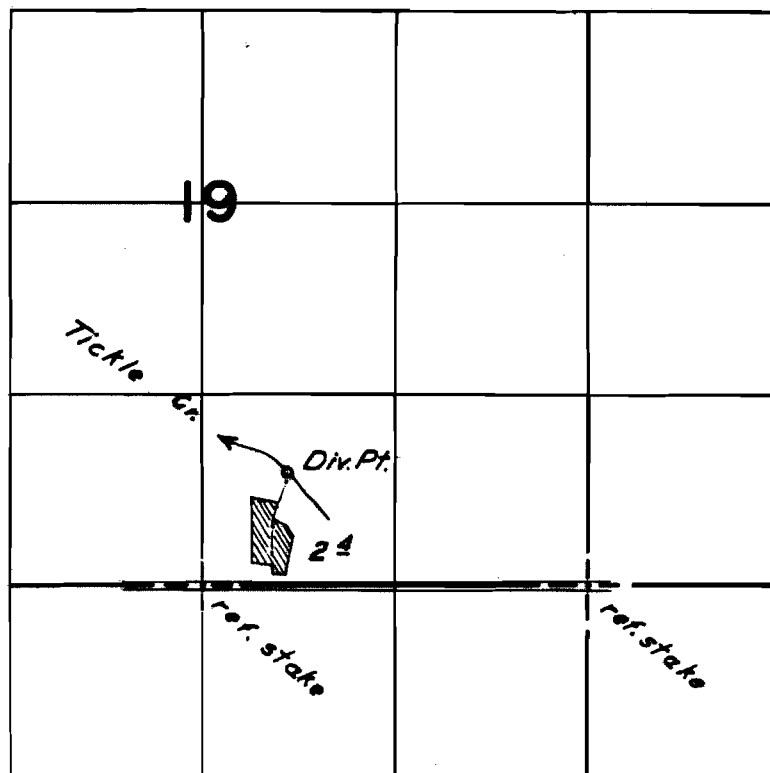

FINAL PROOF SURVEY
UNDER

Application No. 24155 Permit No. 19005
IN NAME OF

George Hartwig

Surveyed Oct. 6 1958, by W.N. Perry