


T.5S. R.2E.W.M.

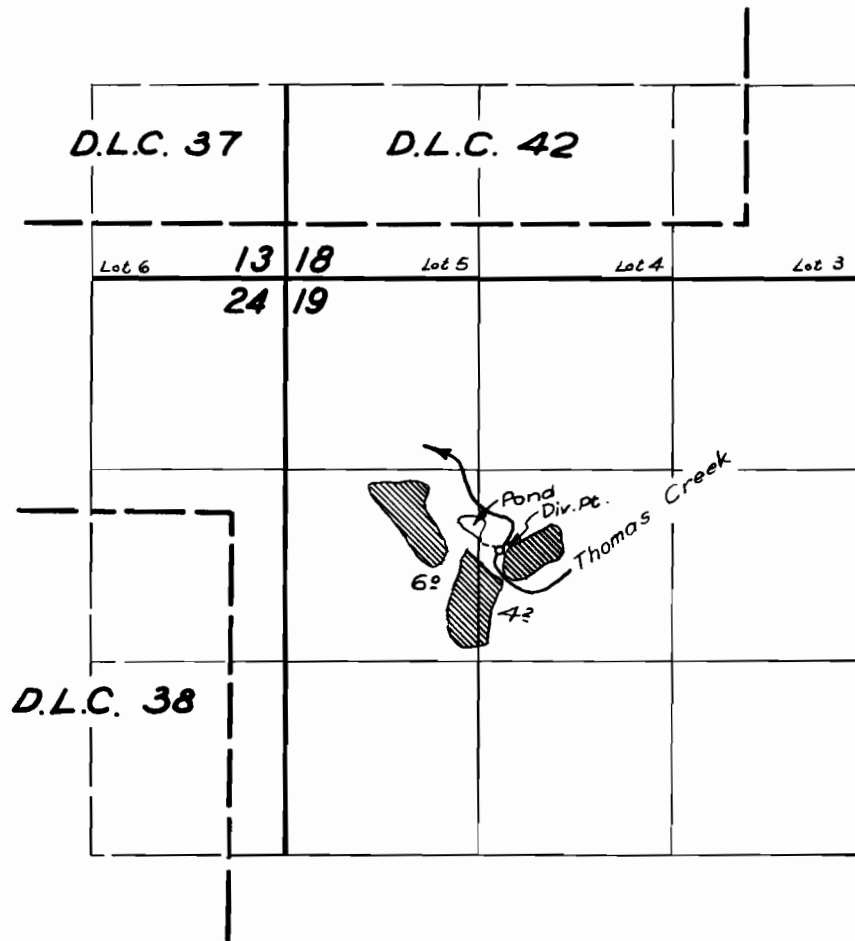

FINAL PROOF SURVEY
UNDER

Application No. 23922. Permit No. 19095
IN NAME OF

G. GEORGE POLACK

Surveyed 7 Oct. 1958, by C.O. Bartels