


T. 3S. R. 2E. W.M.

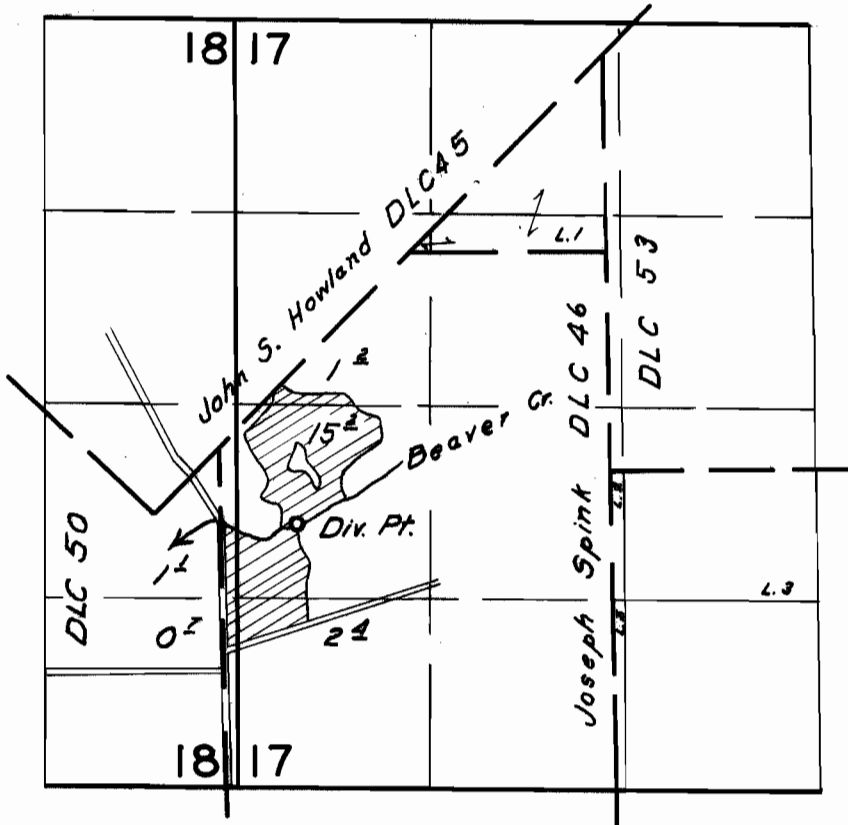

FINAL PROOF SURVEY
UNDER

Application No. 23079 Permit No. 19168
IN NAME OF

John H. & M. Bernice Pryor

Surveyed July 2 1958, by W. N. Perry