


19243

T. 4 S. R. 13 E. W. M.

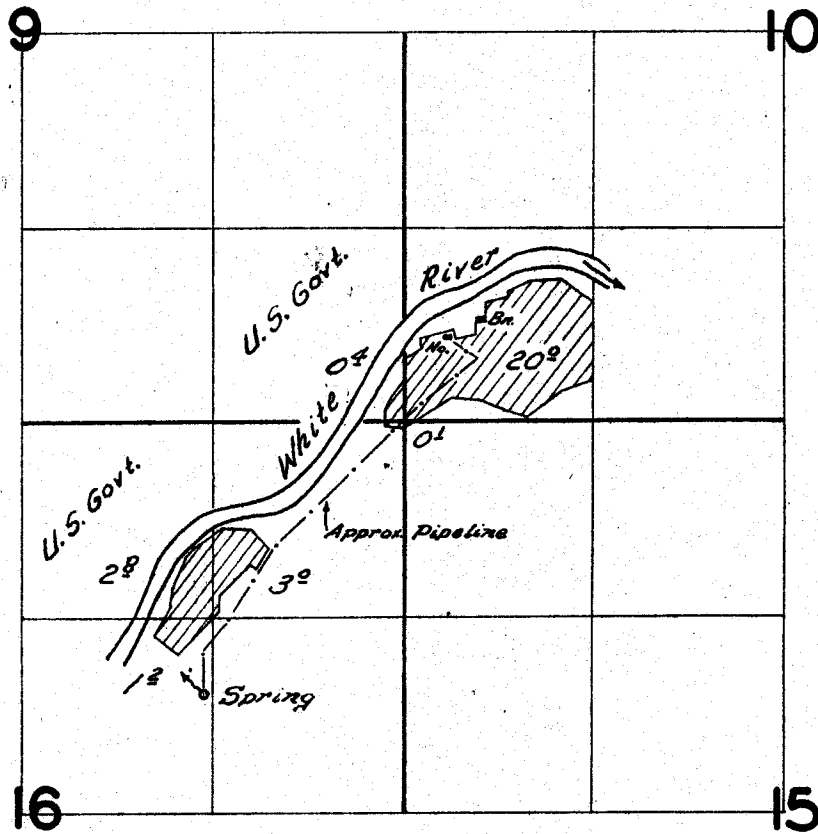

FINAL PROOF SURVEY UNDER

Application No. 24395. Permit No. 19243.
IN NAME OF

PAUL PECK

Surveyed Oct. 8, 1957, by C. D. Bartlett