


T.4 S. R.2W.W.M.

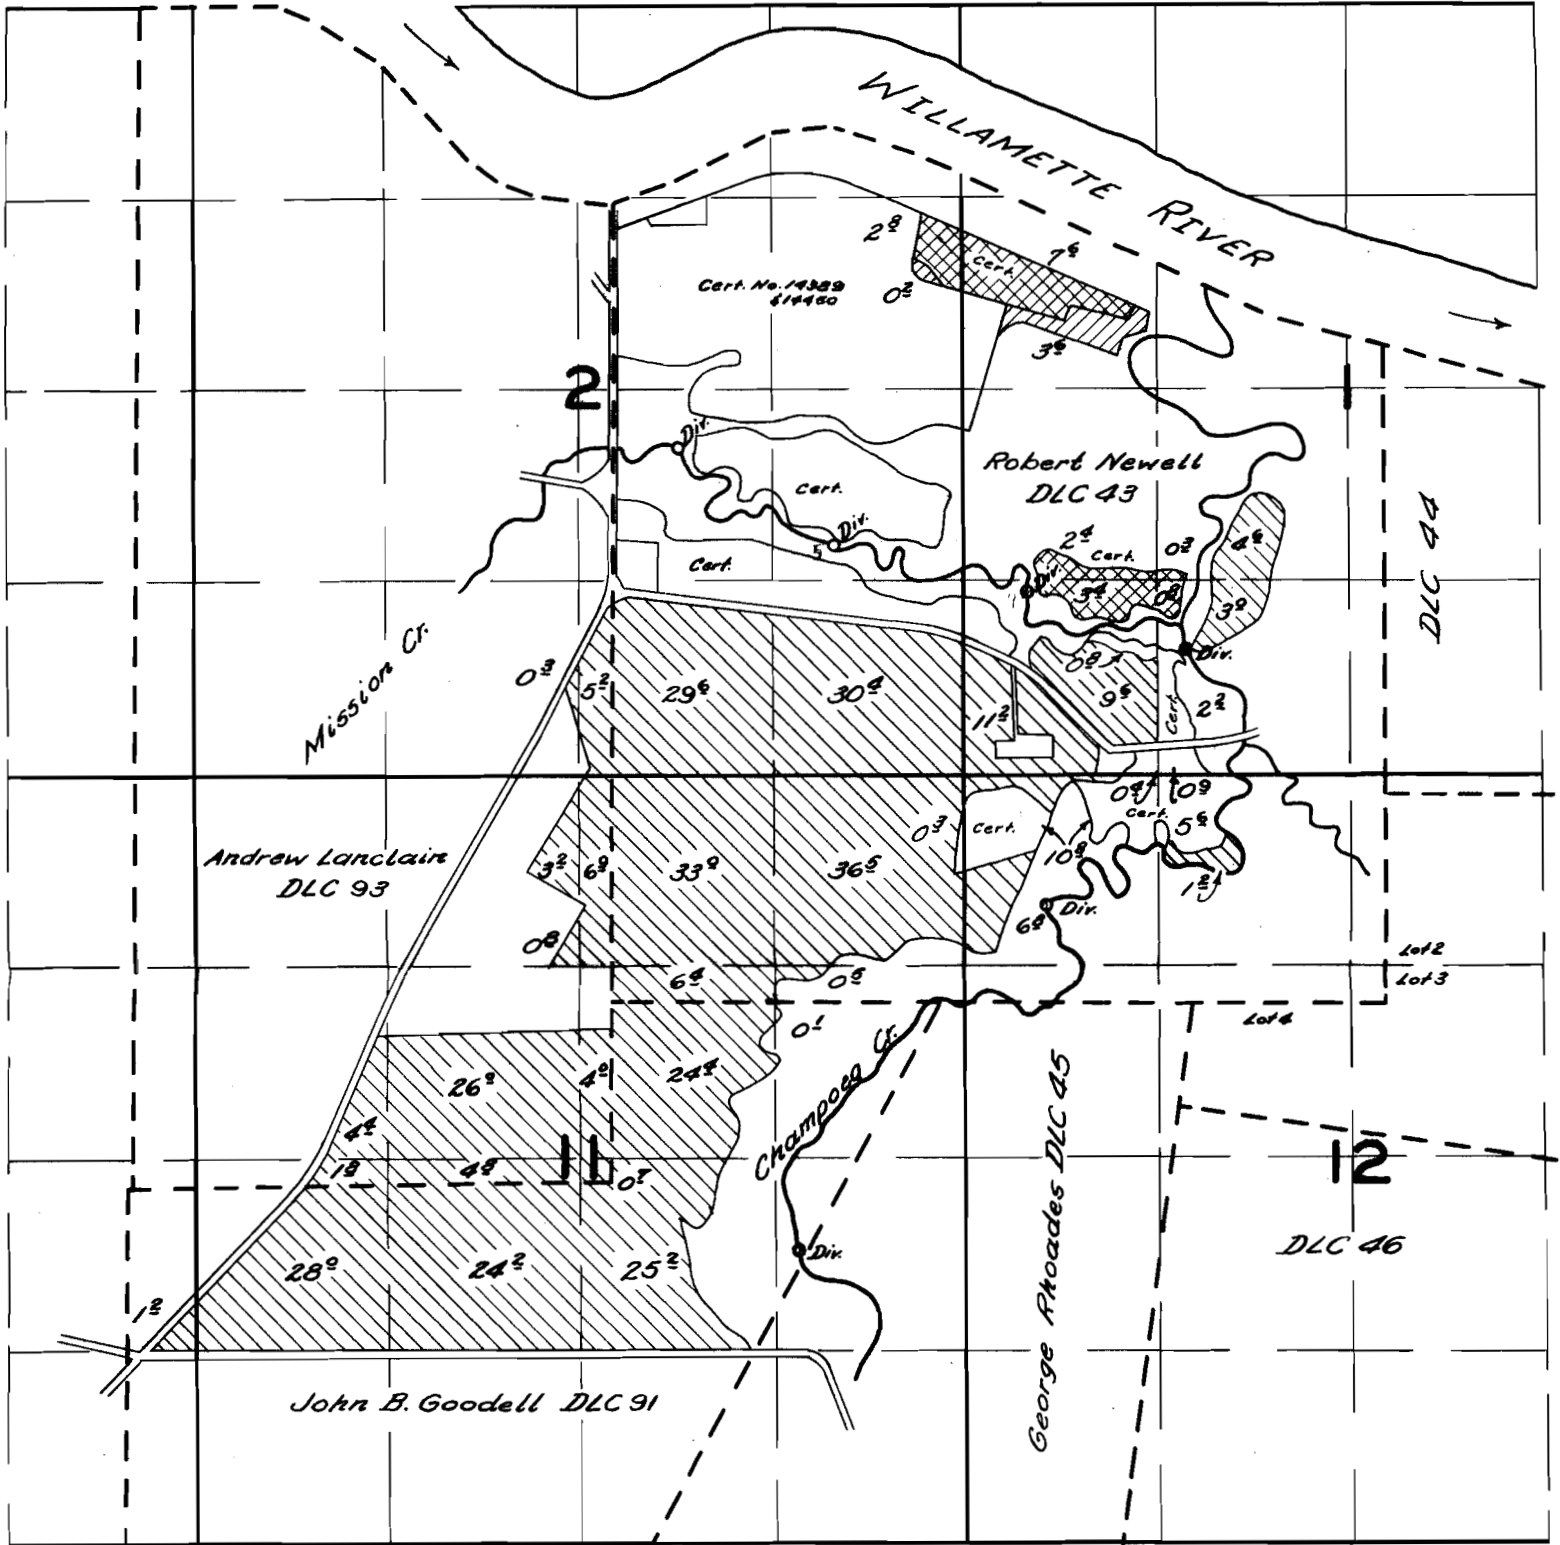

From Champoega Cr.



From Mission Cr.



Supplemental from Mission Cr.

**FINAL PROOF SURVEY**

APPLICATION NO. 24599 PERMIT NO. 19380

Henry Zorn

Surveyed Aug. 19<sup>th</sup> 20, 1958 By Myron Bisk