


T. 11 & 12 S. R. 4 W. W.M.

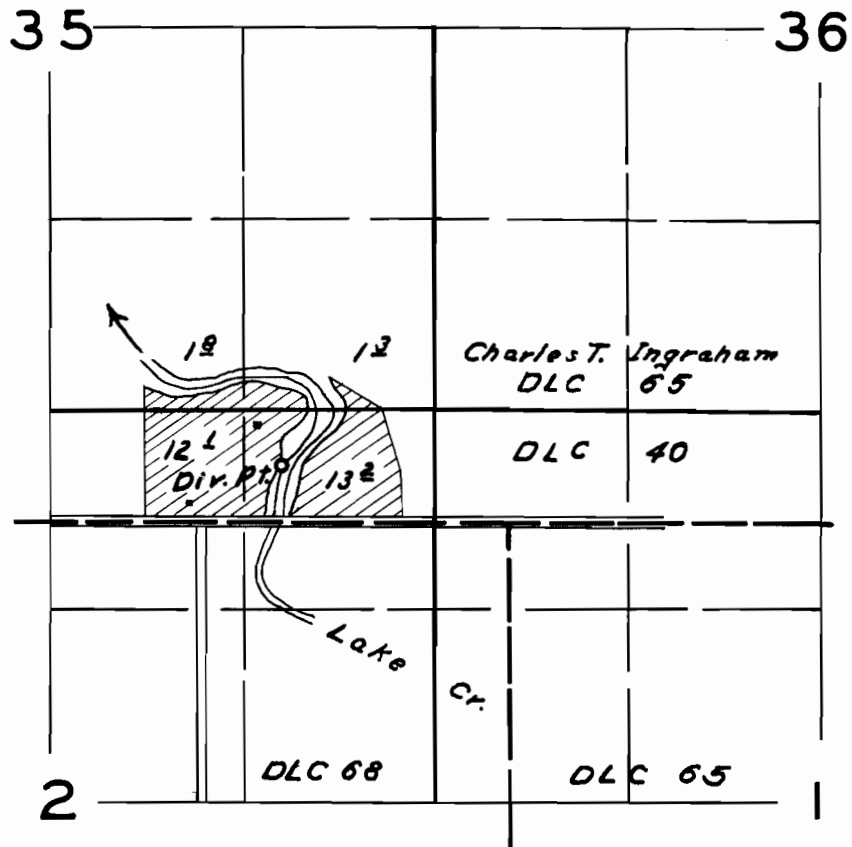

FINAL PROOF SURVEY
UNDER

Application No. 24464 Permit No. 19456
IN NAME OF

M. J. & H. T. Looney

Surveyed Sept. 2, 1958, by W. N. Perry