


T. 3S. R. 2E. W.M.

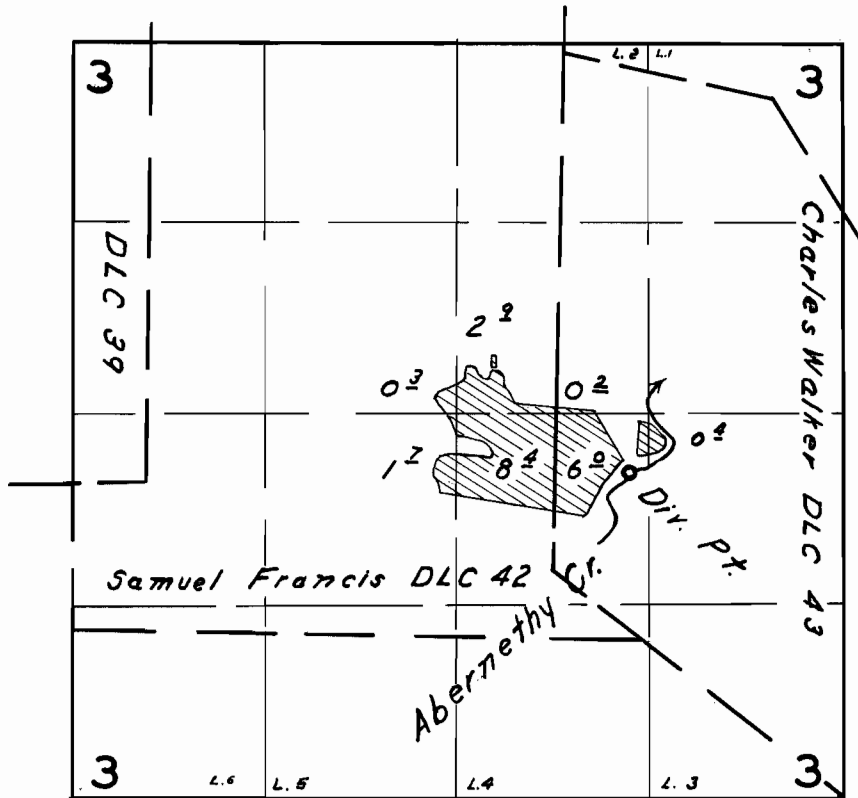

FINAL PROOF SURVEY
UNDER

Application No. 25494 Permit No. 20033
IN NAME OF

Clarence D. & Magdalene Surerus

Surveyed July 3, 1958, by W.N. Perry