


T. 20S. R. 34E. W.M.

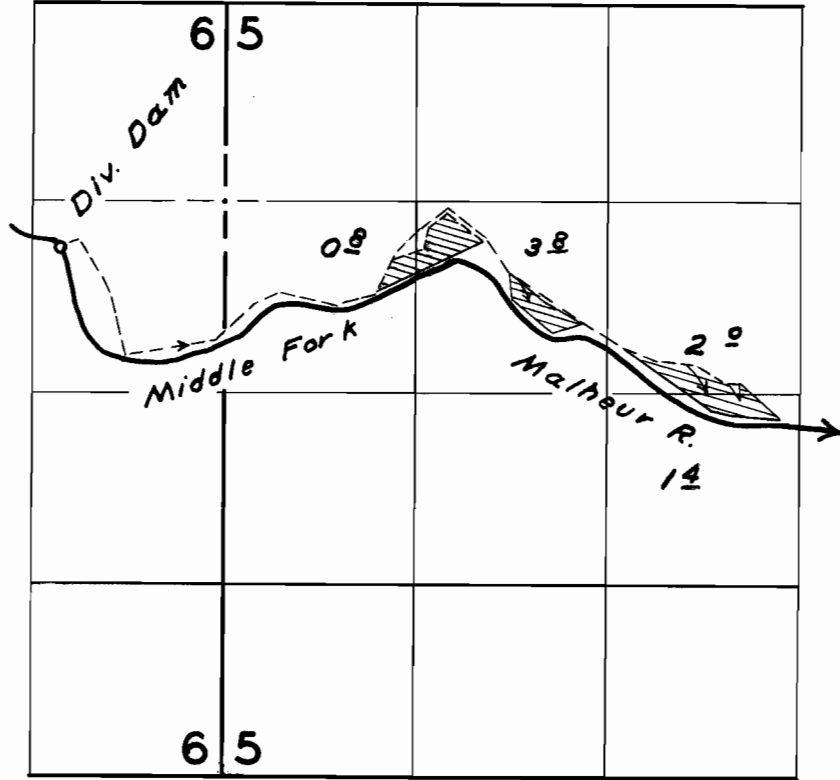

FINAL PROOF SURVEY
UNDER

Application No. 25743 Permit No. 20149
IN NAME OF

George C. Clark

Surveyed Aug 17 1958, by W. N. Perry