


T. 28 S. R. 12 W. WM.

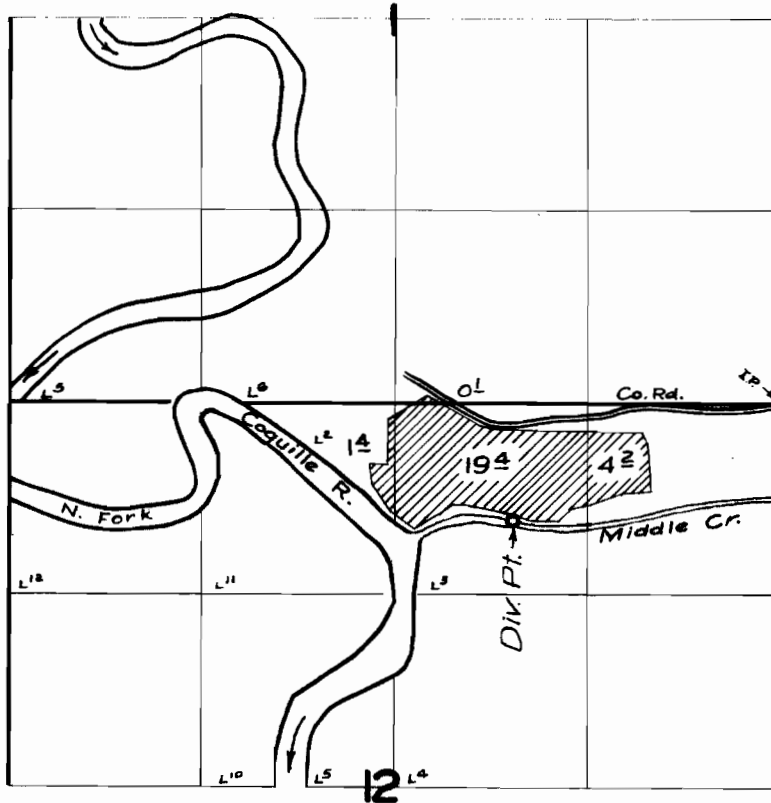

FINAL PROOF SURVEY
UNDER

Application No. 26074... Permit No. 20394...
IN NAME OF

Adam & Dean Heistand

Surveyed 27 May 1958, by *M. Bish*