


T.17S. R.9W.W.M.

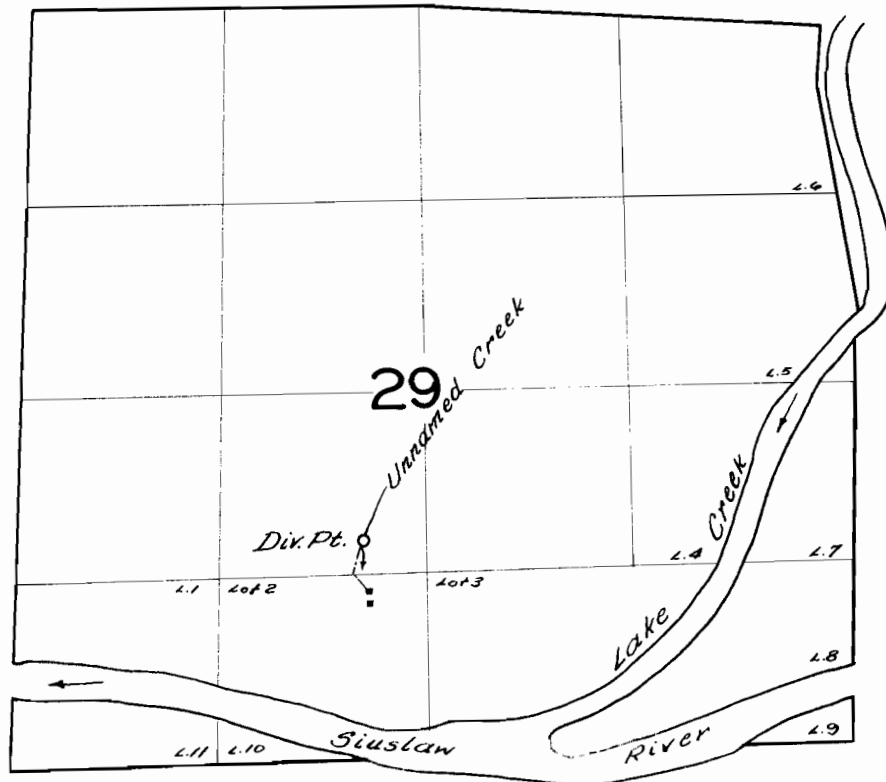

**FINAL PROOF SURVEY**  
UNDER

Application No. 25122 Permit No. 20499  
IN NAME OF

*Delmar J. Lynch*

Surveyed *May 21, 1957*, by *R.H. Whitby*