


T. 2S. R. 4E. W. M.

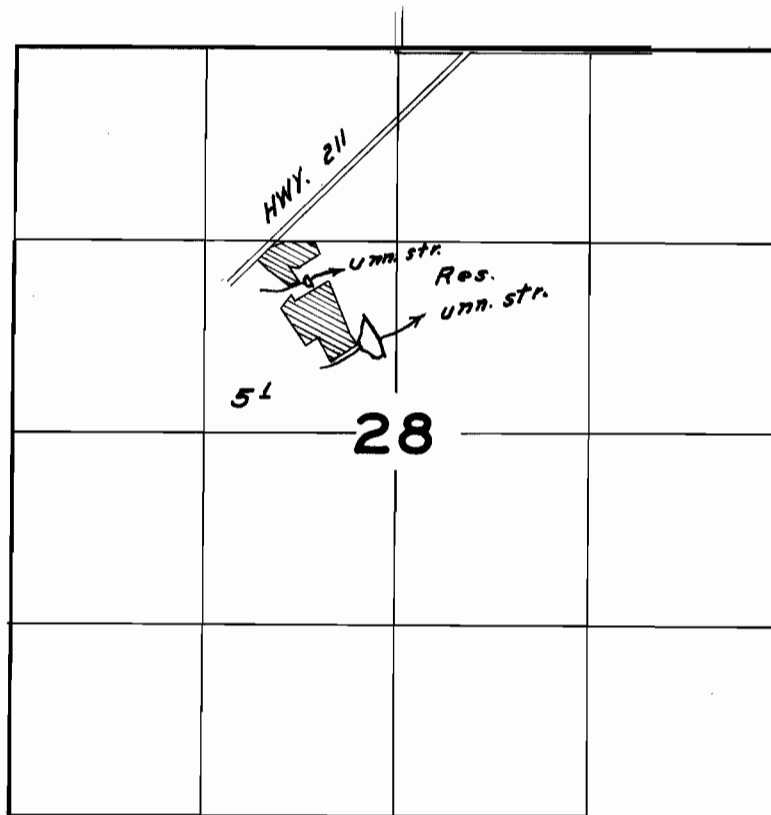

FINAL PROOF SURVEY
UNDER

Application No. R-25176 Permit No. R-1193
25177 IN NAME OF

Melvin J. Knorr

Surveyed June 25 1958, by W. N. Perry