


T.6S. R.1E.W.M.

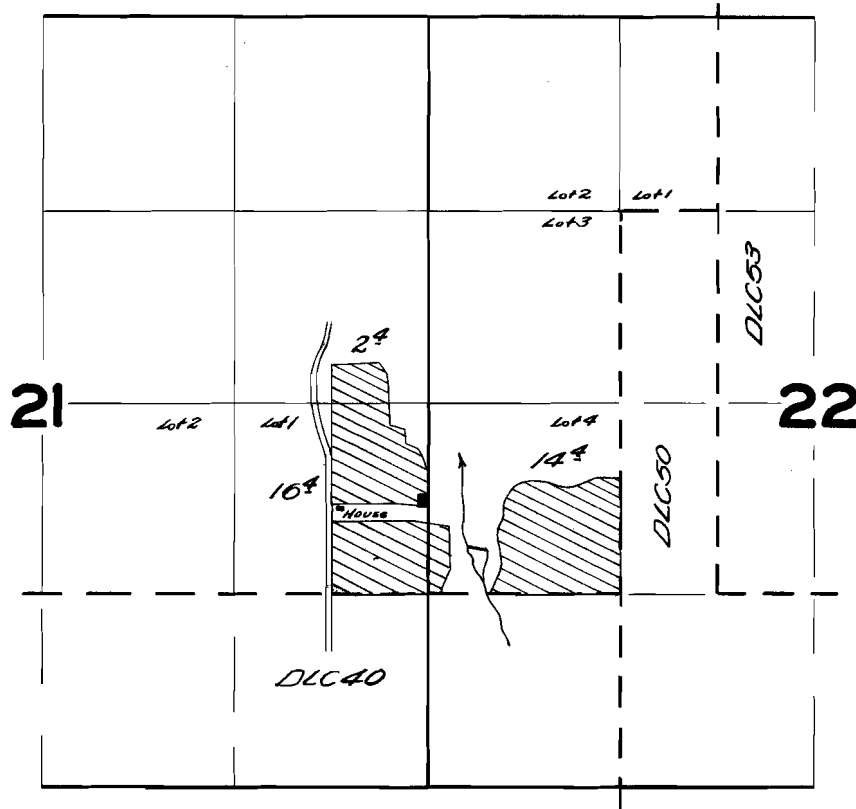

FINAL PROOF SURVEY UNDER

Application No. *R-26416* *26417* Permit No. *R-1251* *20719*
IN NAME OF

Chas. A. Schiedler

Surveyed *April 16* 1958, by *C.O. Bartels*