


# T.6S. R.1E.W.M.

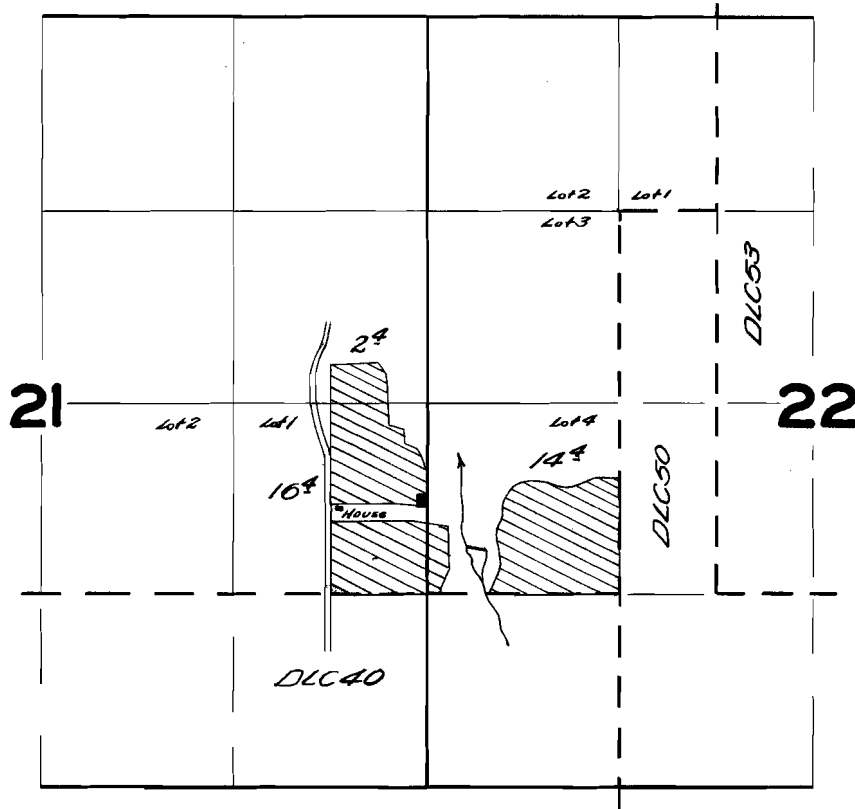

## FINAL PROOF SURVEY UNDER

Application No. *R-26416* *26417* Permit No. *R-1251* *20719*  
IN NAME OF

*Chas. A. Schiedler*

Surveyed *April 16* 1958, by *C.O. Bartels*