


T.28 S.R.14 W.W.M.

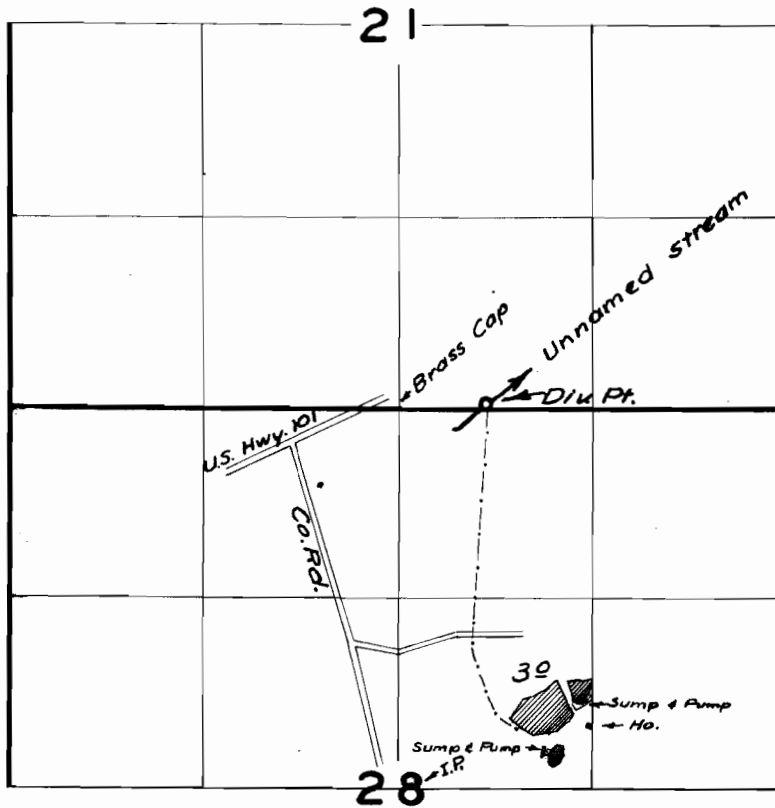

FINAL PROOF SURVEY UNDER

Application No. 26722 Permit No. 21022
IN NAME OF

C.F. St. Sure

Surveyed 20 May 1958, by *m. Bick*