


T.3S. R.3E.W.M.

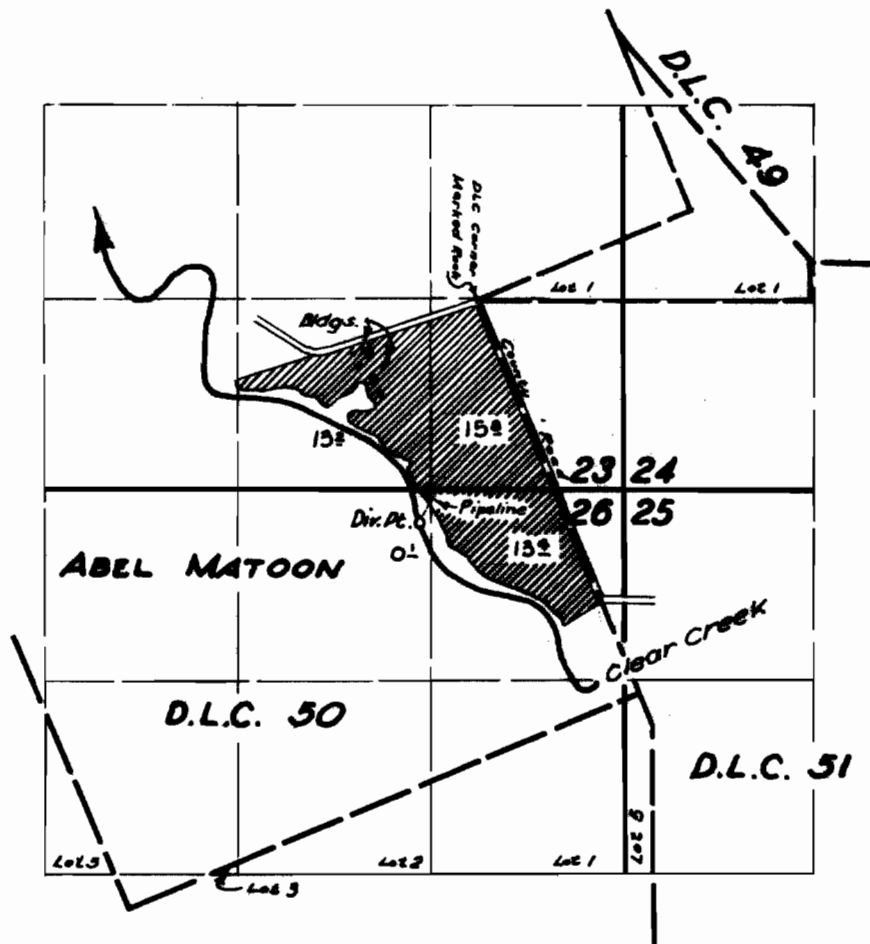

FINAL PROOF SURVEY
UNDER

Application No. 26947. Permit No. 21407.
IN NAME OF

CLEMENT M. & MARY E. LAFETRA

Surveyed 9 Oct. 1958, by C.O. Bartels.