


T. 3N. R. 5 W. W.M.

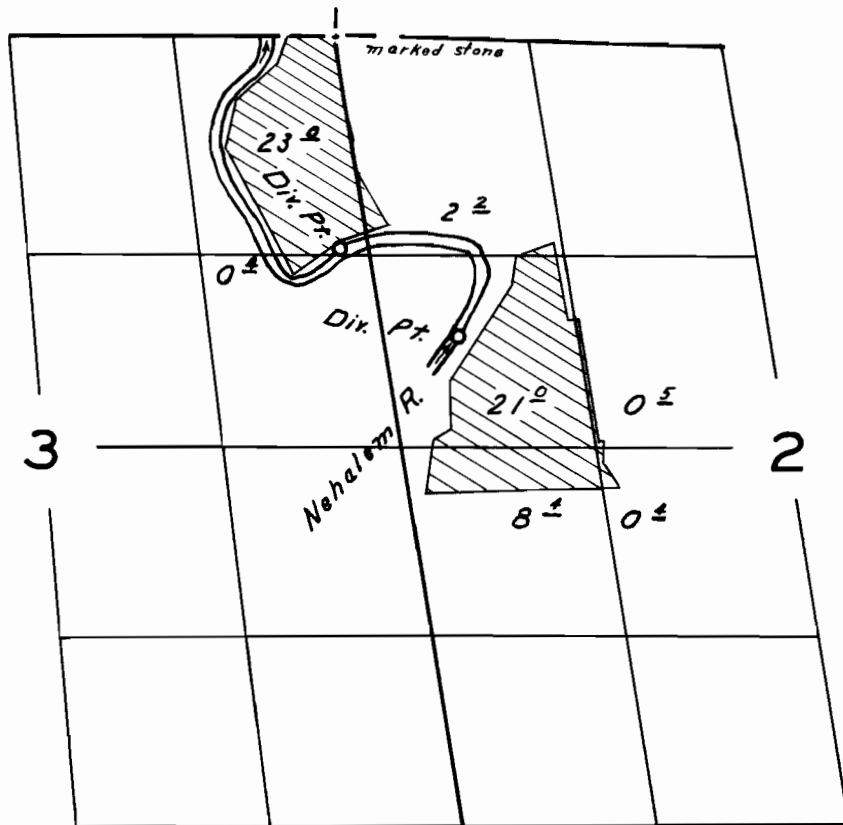

FINAL PROOF SURVEY
UNDER

Application No. *27464* Permit No. *21620*
IN NAME OF

Fred Dixon

Surveyed *May 1* 1958, by *R. H. Whitby*