


T. 4S. R. 4E. W.M.

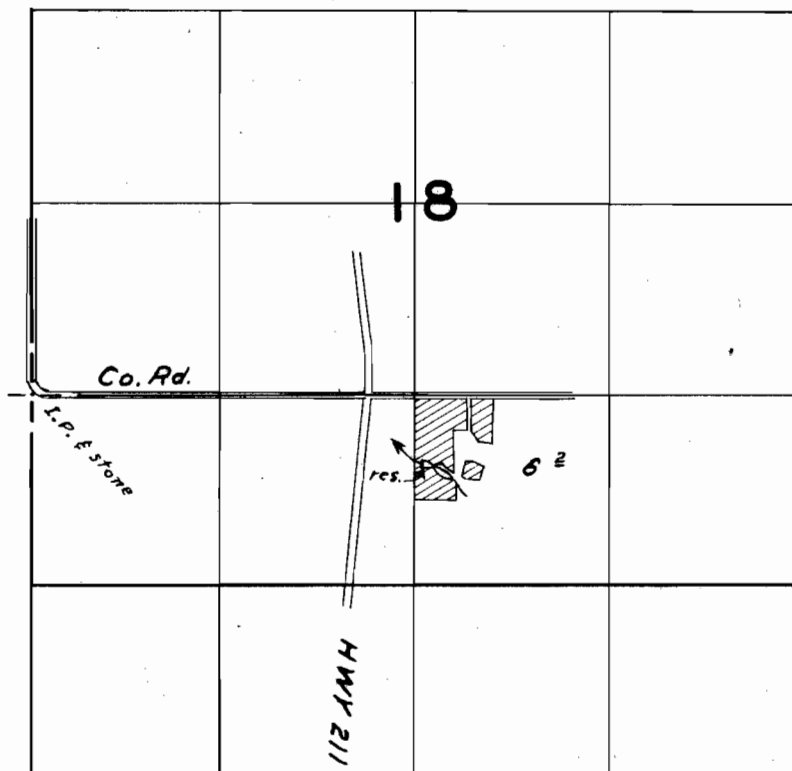

FINAL PROOF SURVEY
UNDER

R-27486 *R-1402*
Application No. *2748.7* Permit No. *21635*
IN NAME OF

John C. Pratt

Surveyed *Oct. 9* 1958, by *W. N. Perry*