


T. 4S. R. 4E. W.M.

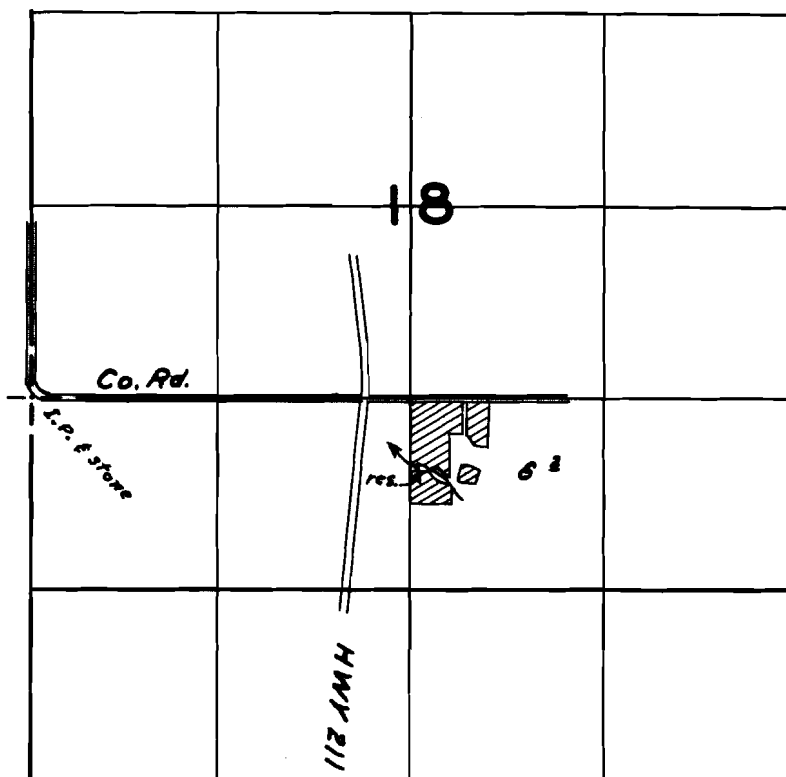

FINAL PROOF SURVEY
UNDER

Application No. *R-27486* *R-1402*
27487 Permit No. *21635*
IN NAME OF

John C. Pratt

Surveyed *Oct. 9* 1958, by *W.N. Perry*