


**T.32 S.R.15 W.W.M.**

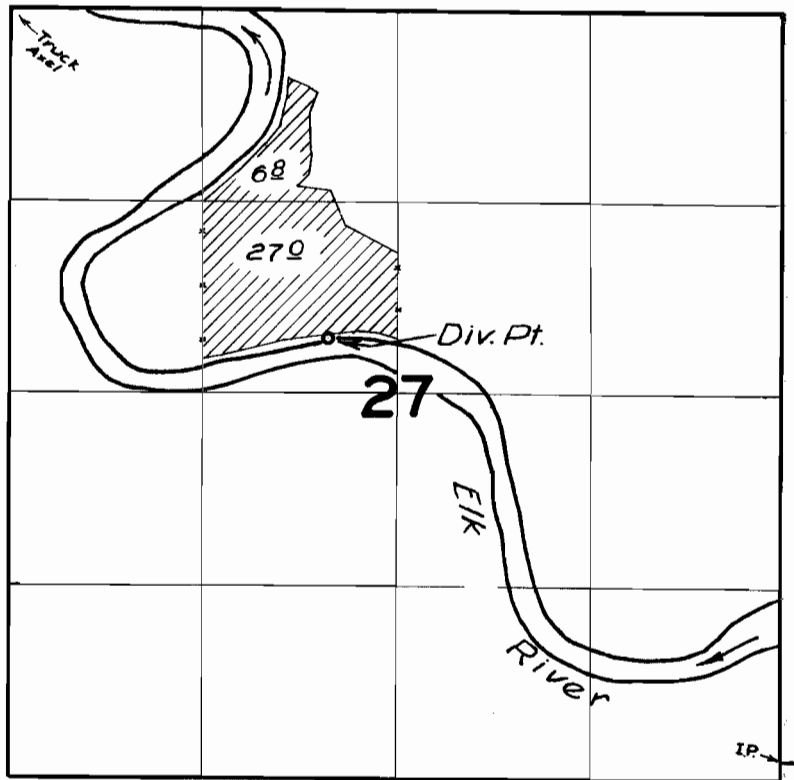

**FINAL PROOF SURVEY**  
UNDER

Application No. 27570 Permit No. 21712  
IN NAME OF

Paul H. Wagner

Surveyed 16 April 1958, by M. Bish