


T. 3S. R. 2E. W.M.

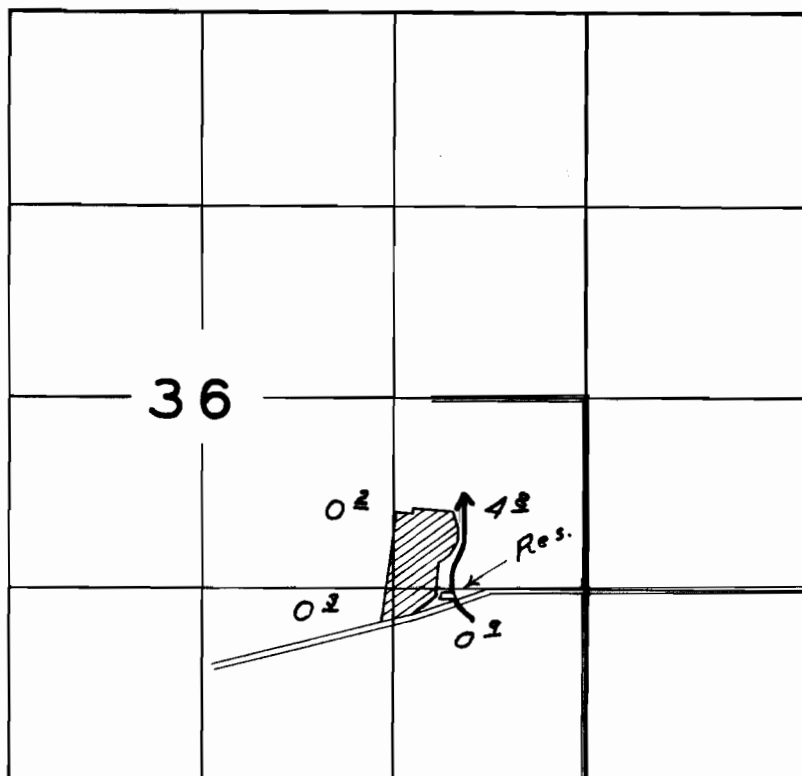

FINAL PROOF SURVEY
UNDER

R-27888 *R-1439*
Application No. *27889* Permit No. *21826*
IN NAME OF

Vernon B. & J. Maude Bagley

Surveyed *July 2*, 1958, by *W.M. Perry*