


T. 1 S. R. 2 W. W. M.

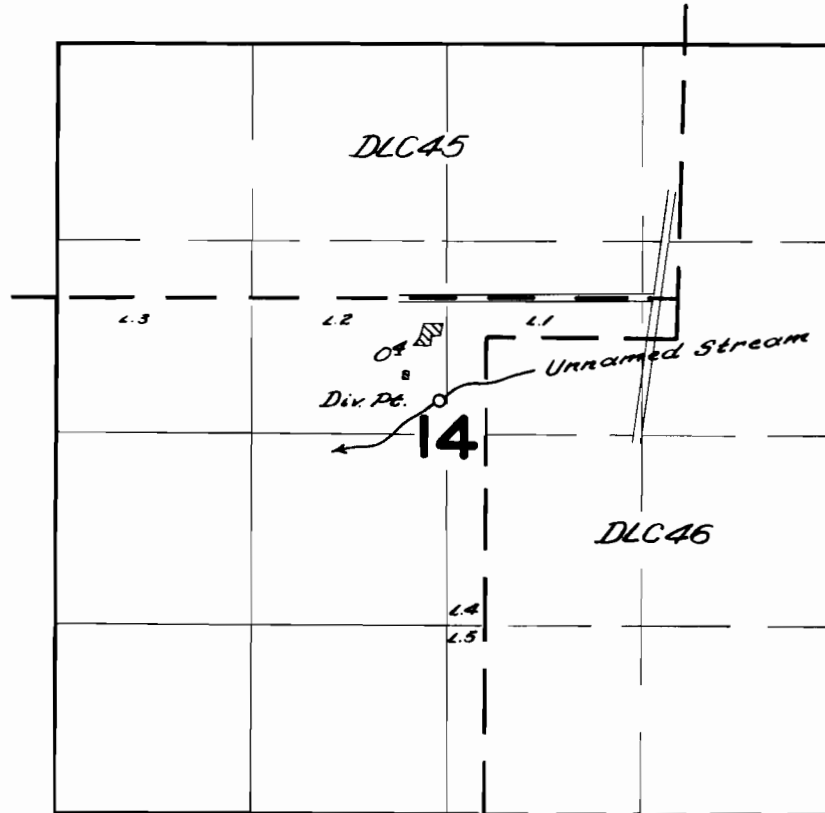

FINAL PROOF SURVEY UNDER

Application No. 26077 Permit No. 21918
IN NAME OF

Arthur A. Carlson

Surveyed *April 8* 1958, by *C.O. Burt*