


# T. 4 S. R. 1 W. W. M.

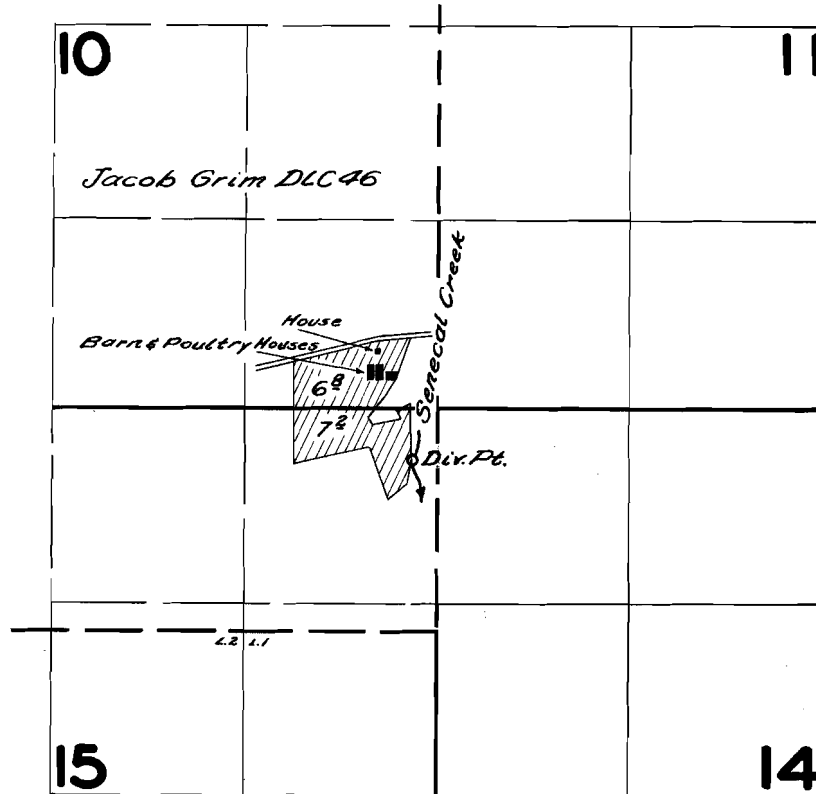

## FINAL PROOF SURVEY UNDER

Application No. 27837... Permit No. 21951...  
IN NAME OF

*Geo. H. & Blanche F. Rowlett*

Surveyed June 9, 1958, by *C. O. Bartels*