


# T.6S. R.1E.W.M.

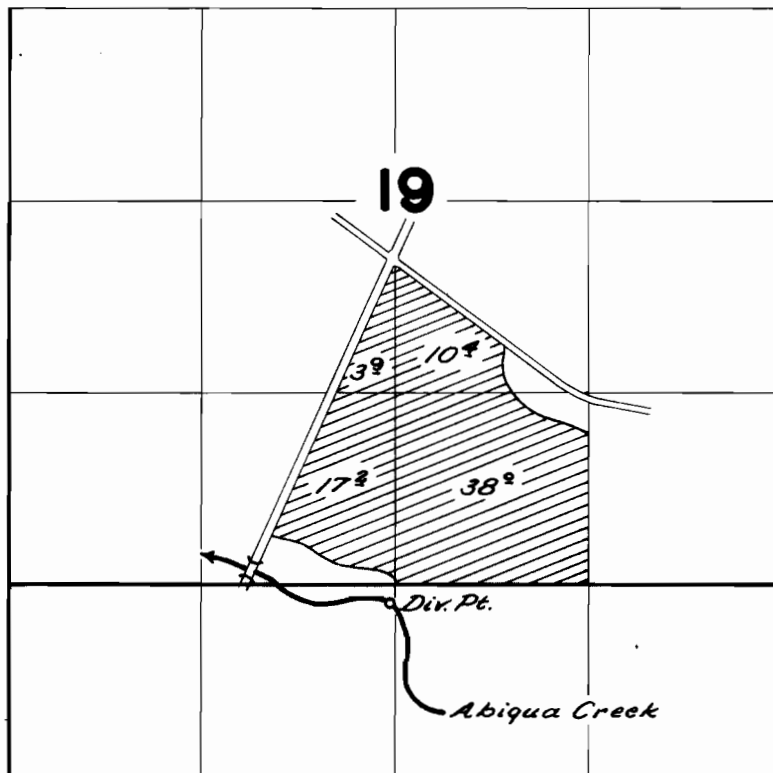

## FINAL PROOF SURVEY UNDER

Application No. 27906 .. Permit No. 21980 ..  
IN NAME OF

*Harvey E. Gekring*

Surveyed April 21, 1958, by *C.O. Bartels*