


T.28S.R.12W.W.M.

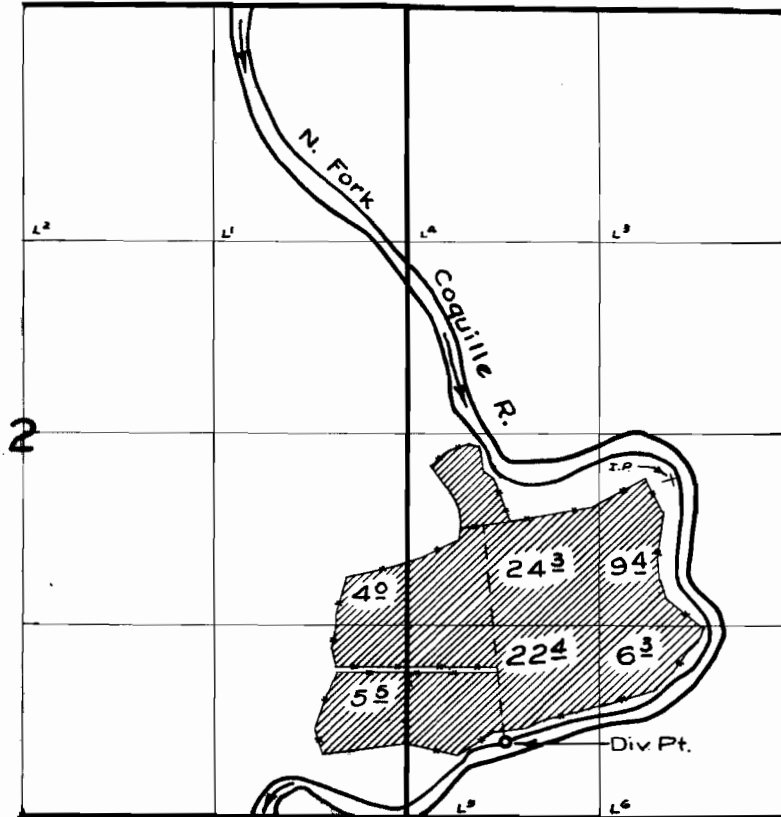

FINAL PROOF SURVEY UNDER

Application No. 28029 Permit No. 22053
IN NAME OF

Hollis Mast

Surveyed 27 May 1958 by M. Bish