


T. 2S. R. 4E. W.M.

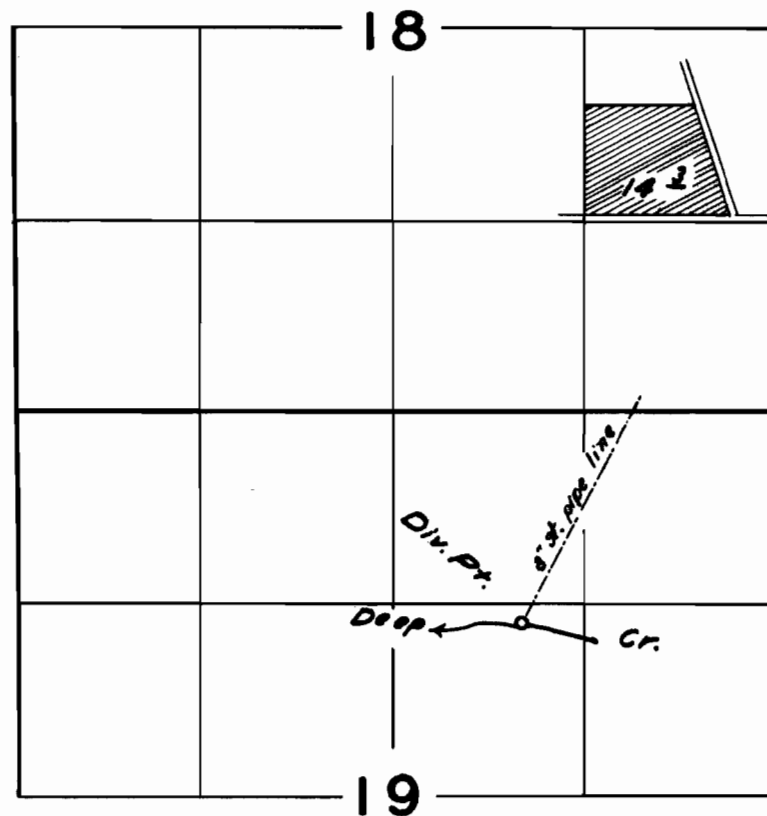

FINAL PROOF SURVEY
UNDER

Application No. 22085 Permit No. 22086
IN NAME OF

Schedeen Bros. - R.E. & Les Schedeen

Surveyed Aug. 26 1958, by W.N. Perry