


T.9S.R.45E.WM.

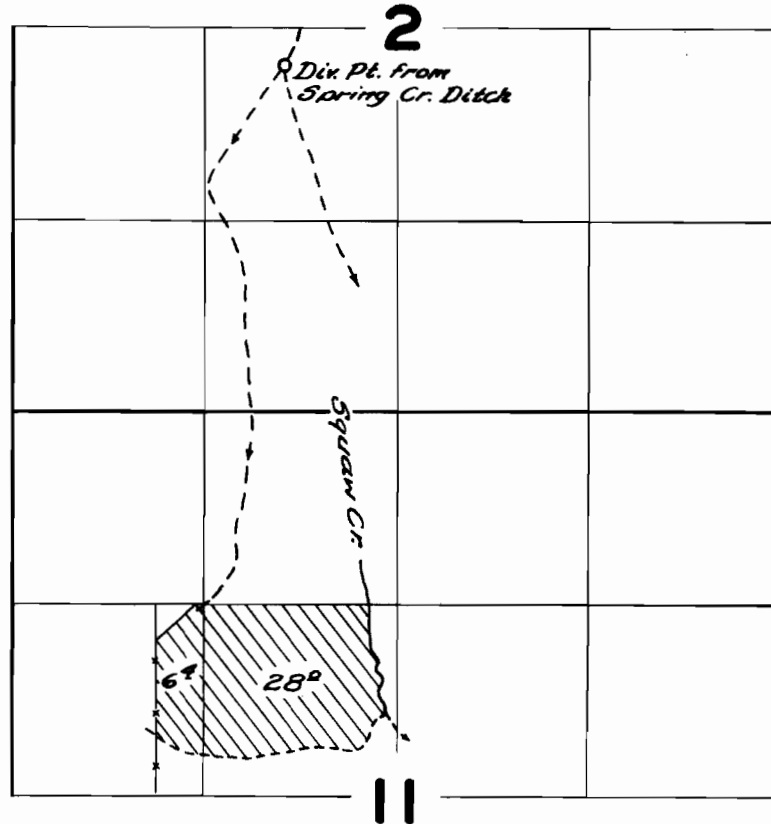

FINAL PROOF SURVEY UNDER

Application No. 27953. Permit No. 22108.
IN NAME OF

.....*Carl C. Carrahan*.....

Surveyed *Sept 23* 1958, by *Q.D. Bartels*.....