


T.4S. R.2W.W.M.

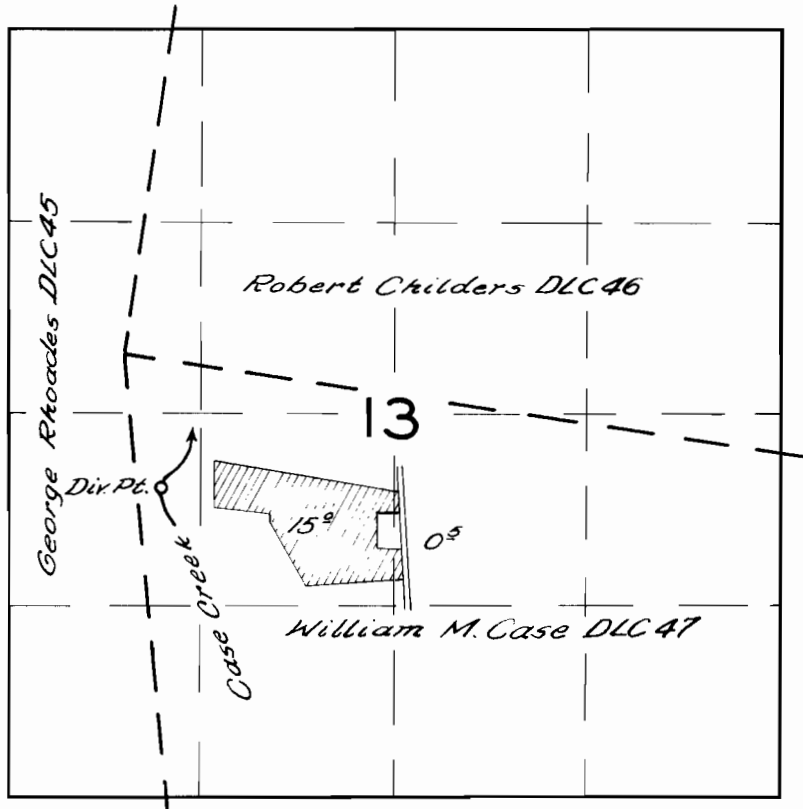

FINAL PROOF SURVEY
UNDER

Application No. 28124 Permit No. 22137
IN NAME OF

James H. Hadley

Surveyed *April 25 1958*, by *C.O. Burtels*