


T.9S.R.2W.W.M.

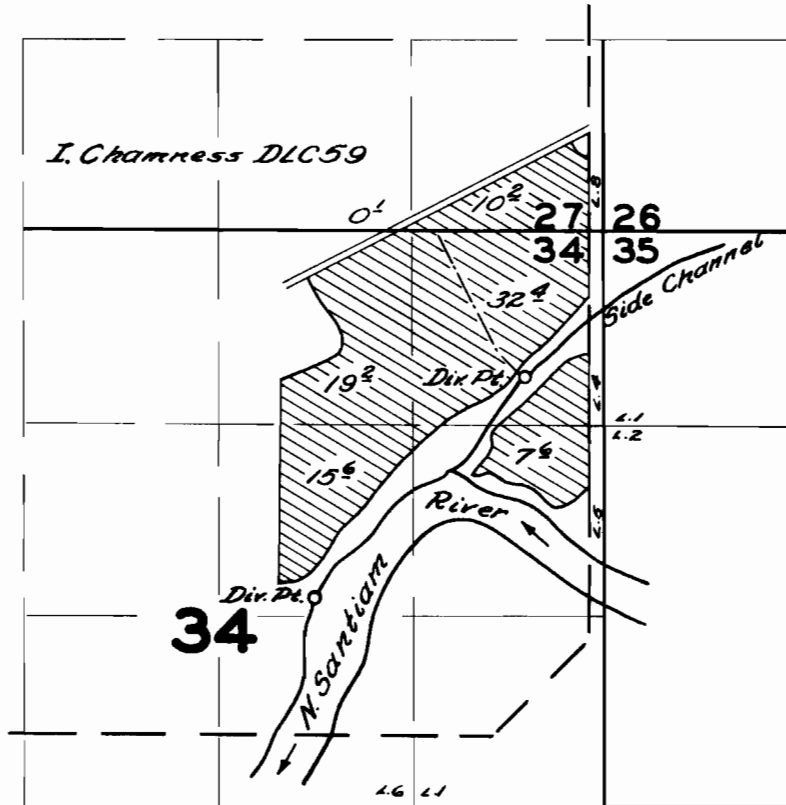

FINAL PROOF SURVEY UNDER

Application No. 28144 Permit No. 22150
IN NAME OF

Y. M. McGill

Surveyed *May 19 1958*, by *C. O. B. [Signature]*