


T.5S. R.1W.W.M.

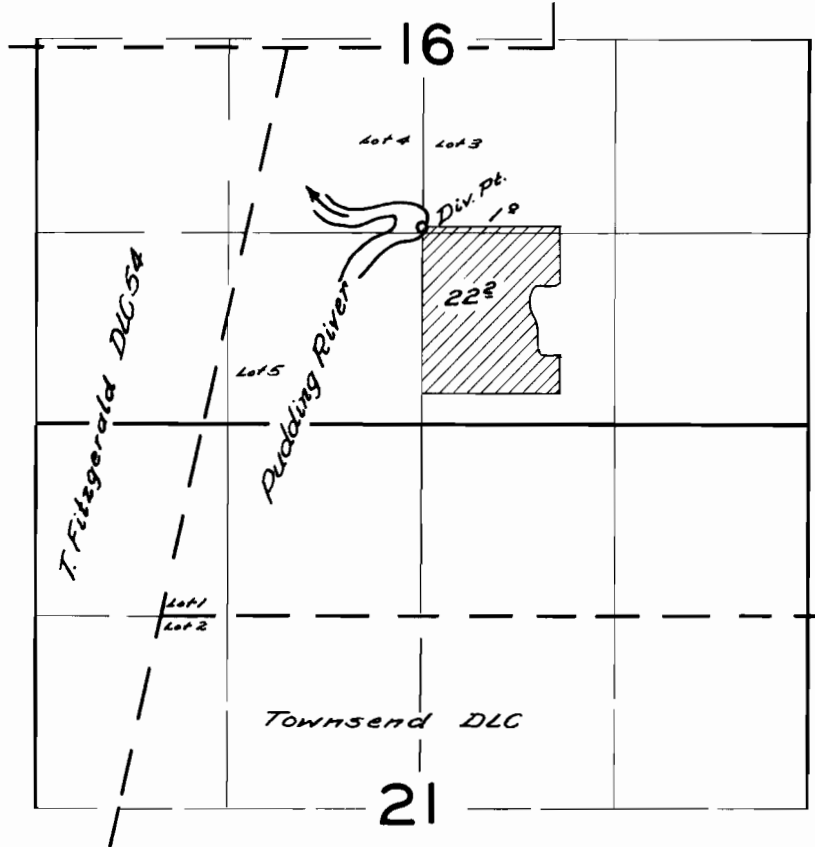

FINAL PROOF SURVEY
UNDER

Application No. 28145 Permit No. 22151
IN NAME OF

A.W. Beckford

Surveyed April 23 1958, by C.D. Smith