


T. 1N. & 1S. R. 2W. W.M.

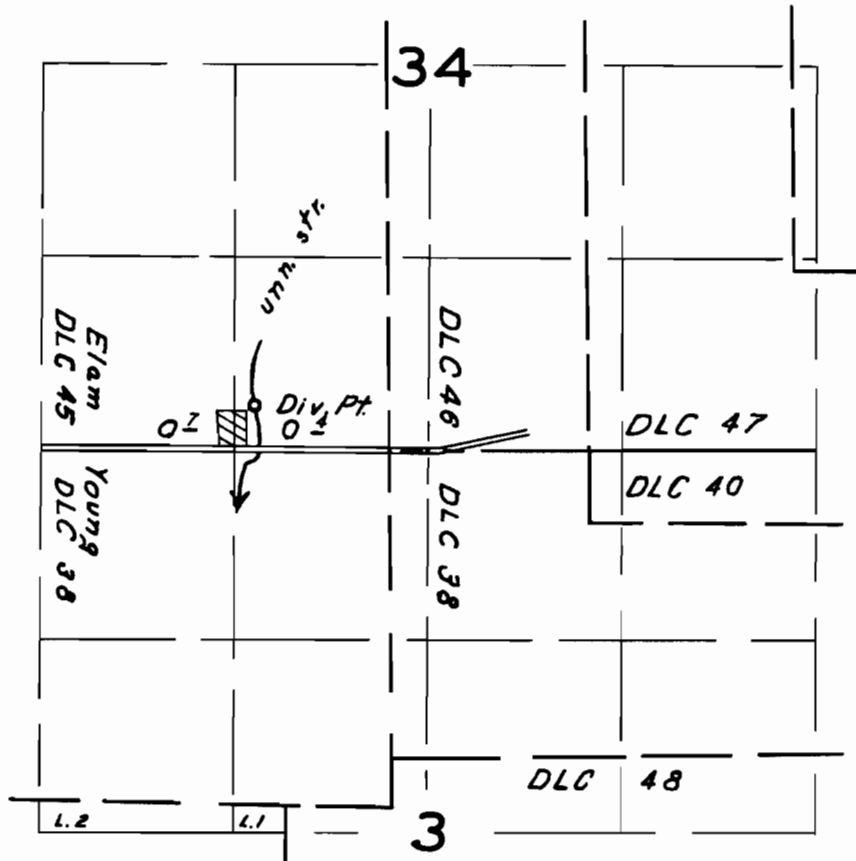

FINAL PROOF SURVEY
UNDER

Application No. 28202 Permit No. 22190
IN NAME OF

Ernest Wilfert

Surveyed May 5 1958, by R. H. Whitby