


T. 2S. R. 2E. W. M.

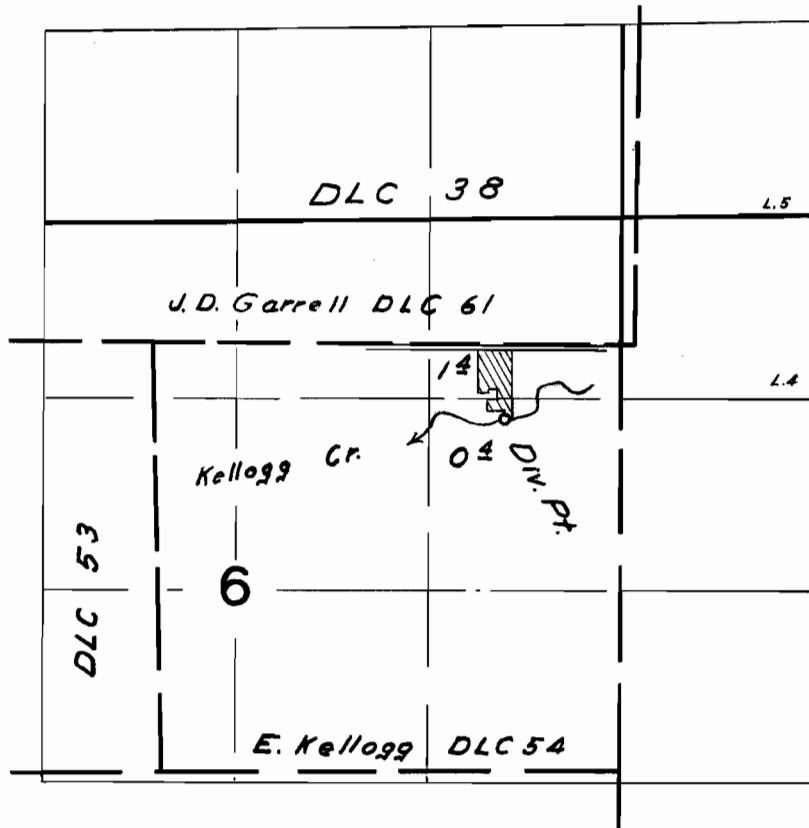

**FINAL PROOF SURVEY**  
UNDER

Application No. 27531 Permit No. 22345  
IN NAME OF

Ralph R. Kendig

Surveyed July 11 1958, by W.N. Perry