


T. 2S. R. 5E. W. M.

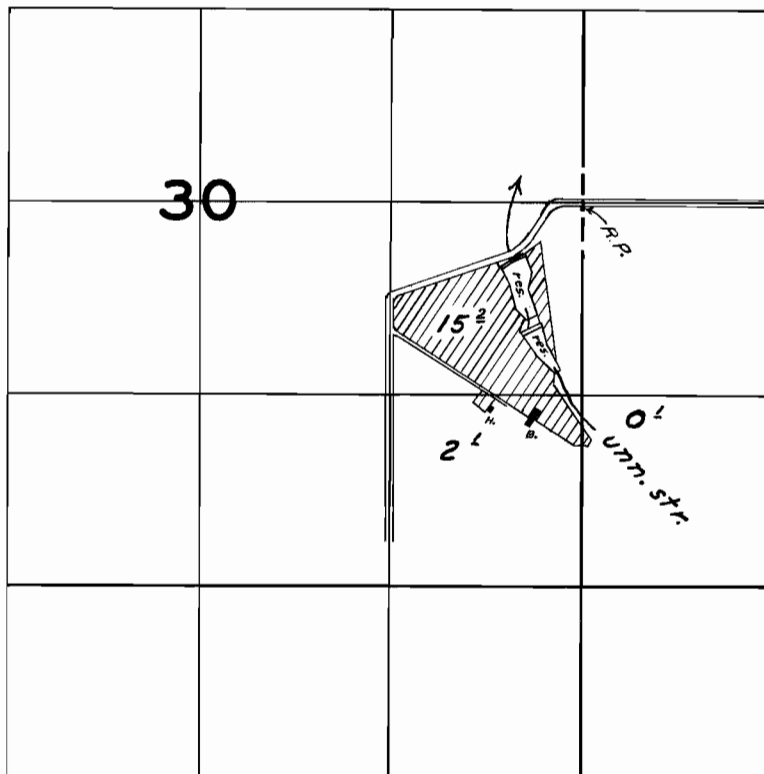

FINAL PROOF SURVEY
UNDER

Application No. R-28370 R-1507
28371 Permit No. 22384
 IN NAME OF

A. J. Updegrave

Surveyed Oct. 3 1958, by W. N. Perry