


T. 2 S. R. 5 E. W. M.

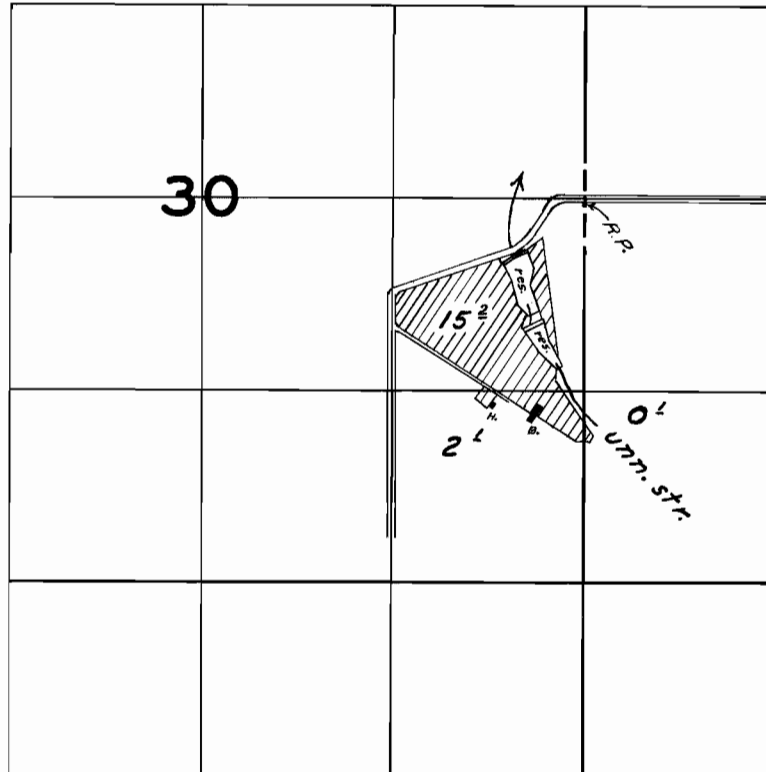

FINAL PROOF SURVEY
UNDER

R-28370 *R-1507*
Application No. *28371* Permit No. *22384*
IN NAME OF

A. J. Updegrave

Surveyed *Oct. 3* 1958, by *W. N. Perry*