


T.17S. R.9W.W.M.

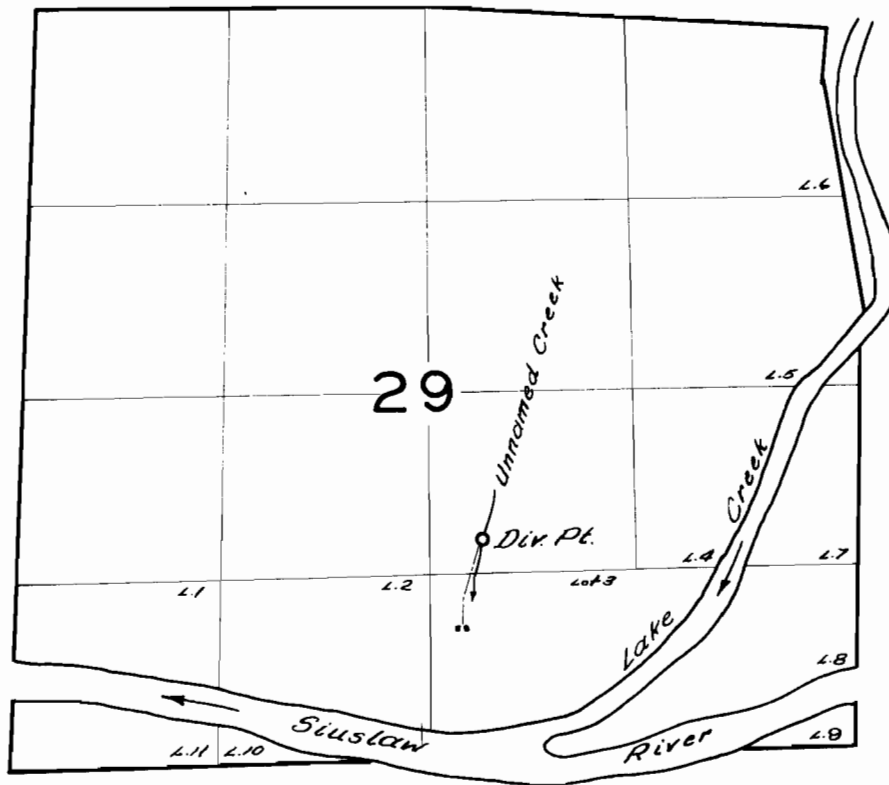

**FINAL PROOF SURVEY**  
UNDER

Application No. 22841 Permit No. 22412  
IN NAME OF

*Sam Haywood Lyncht*

Surveyed *May 15, 1957*, by *R.H. Whitby*