


Corner to Secs. 2, 3, 10, & 11,
T. 5 S., R. 1 E., W. 1 M.
1" Iron pipe Ref. Mon.

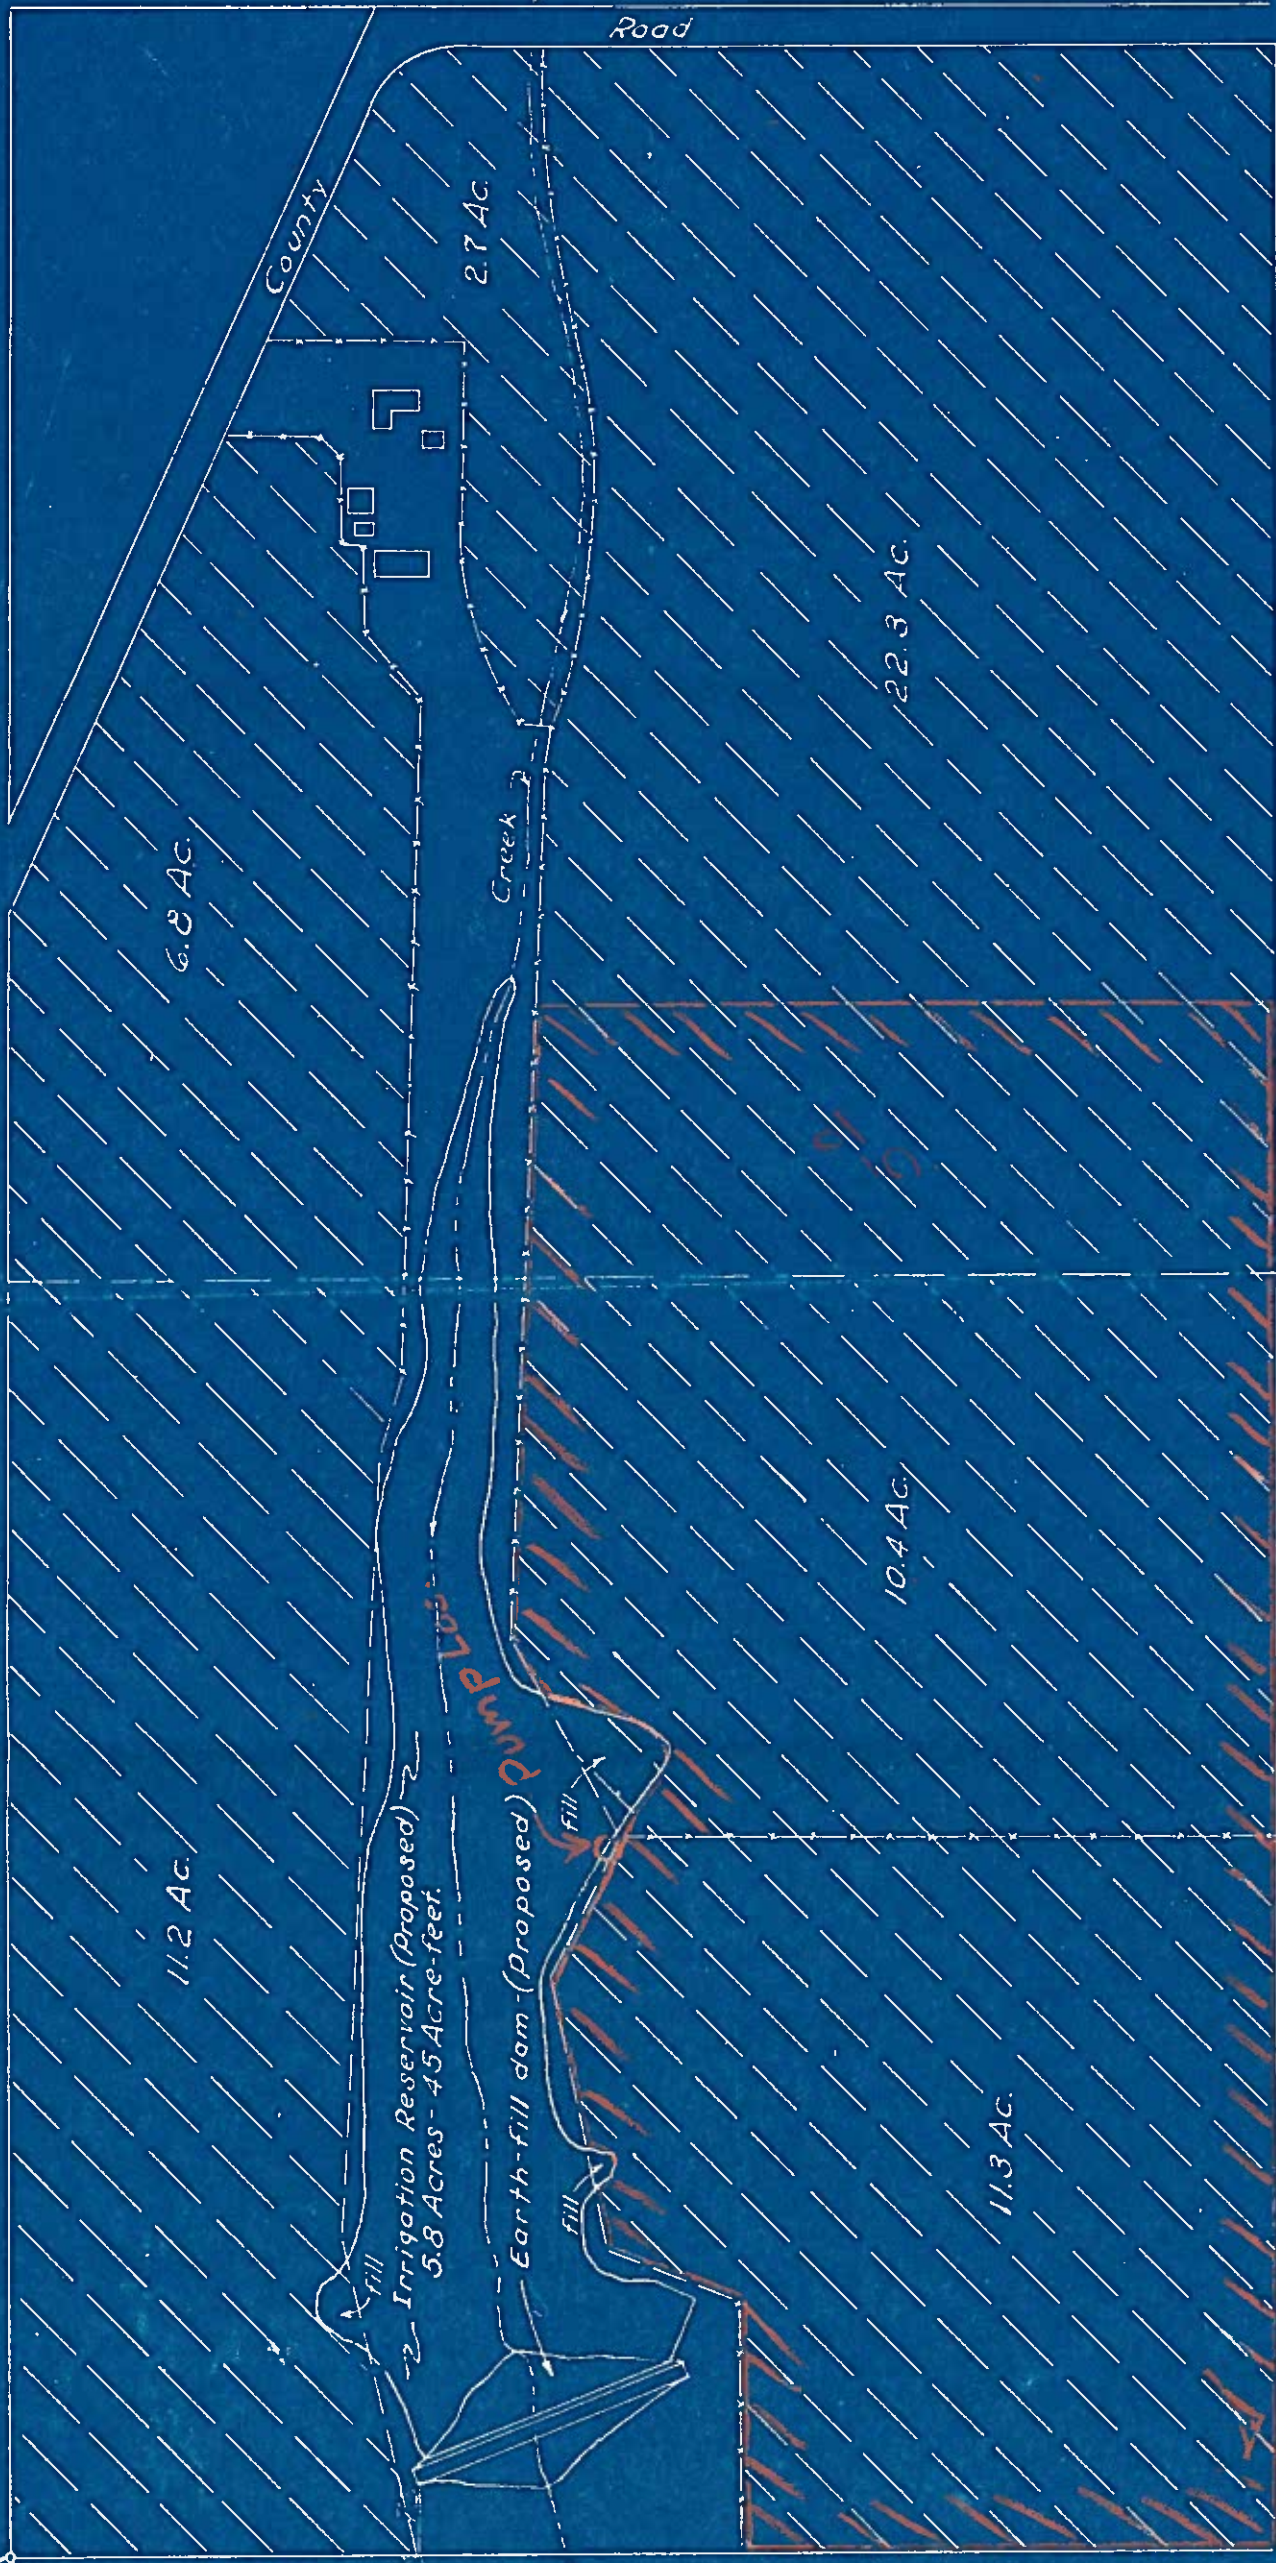

MAP
OF PROPOSED IRRIGATION by HENRY KYLLO of 64.7 Acres in
N 1/2 NW 1/4 Sec 11, T. 5 S., R. 1 E., W. 1 M. - to accompany application for permit.

Scale: 1" = 200'

Irrigation will be by portable
pumping from reservoir.

I, Carvel B. Case, of Portland, Oregon, do hereby
certify that this map was made from notes
taken during an actual survey made by me
July 25, 1953.



R-28814
28820
A-1578

22680

Irrigated to date, June 20, 1958