


T. 40-41S. R. 19E. W.M.

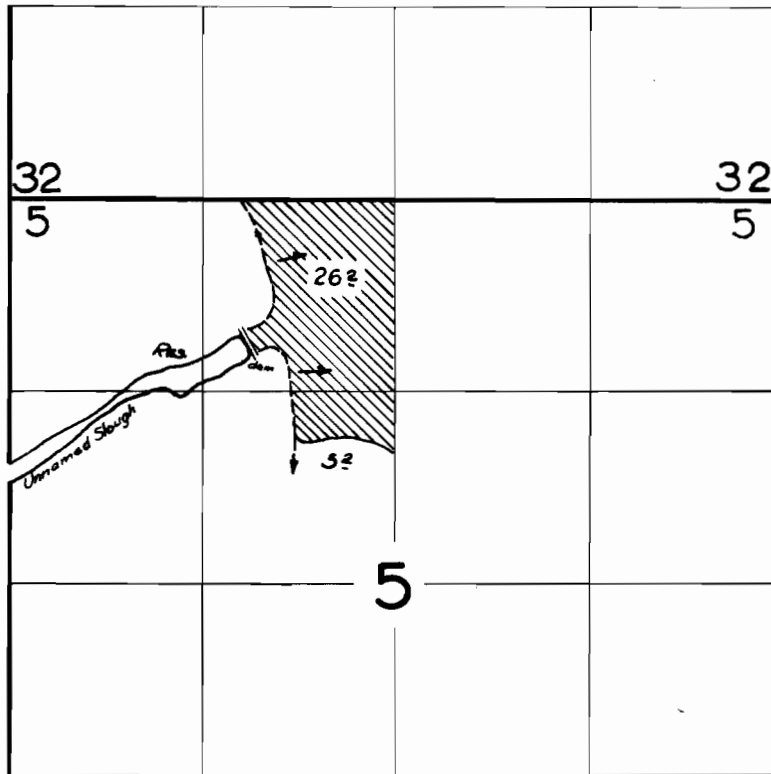

FINAL PROOF SURVEY
UNDER

Application No. ^{R-28991} 28934 Permit No. ^{R-1596} 22762
IN NAME OF

SOUTHERN OREGON RANCHES, INC.

Surveyed 6 May 1959, by *R. Jackson*