


T.5S. R.1W.W.M.

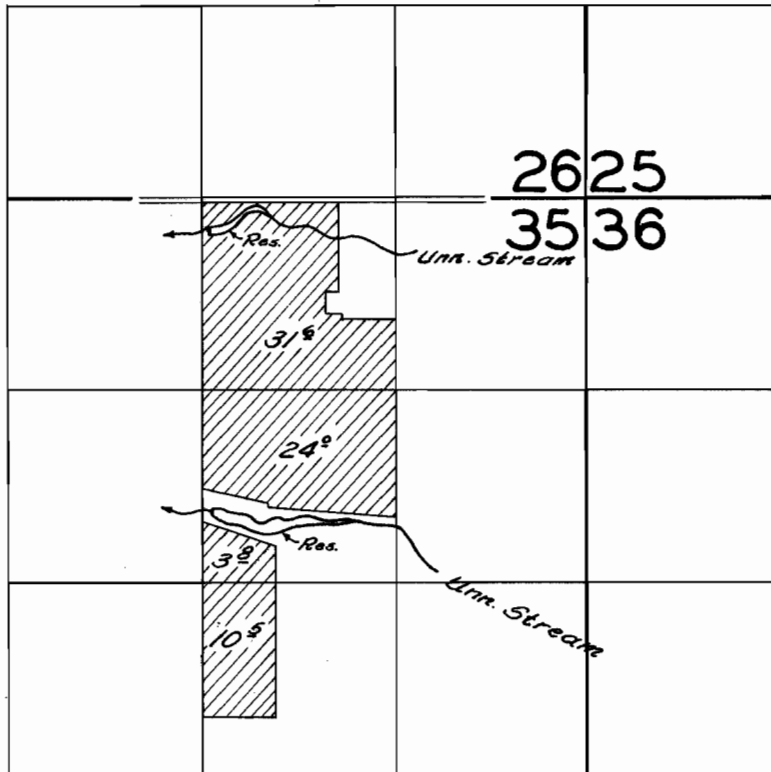

FINAL PROOF SURVEY
UNDER

Application No. ^{R-28763} ~~28764~~ Permit No. ^{R-1644} ~~23058~~
IN NAME OF

..... *Ed. Zach*

Surveyed *April 25 1958*, by *C. O. Castello*