


# T.30S.R.15 W.W.M.

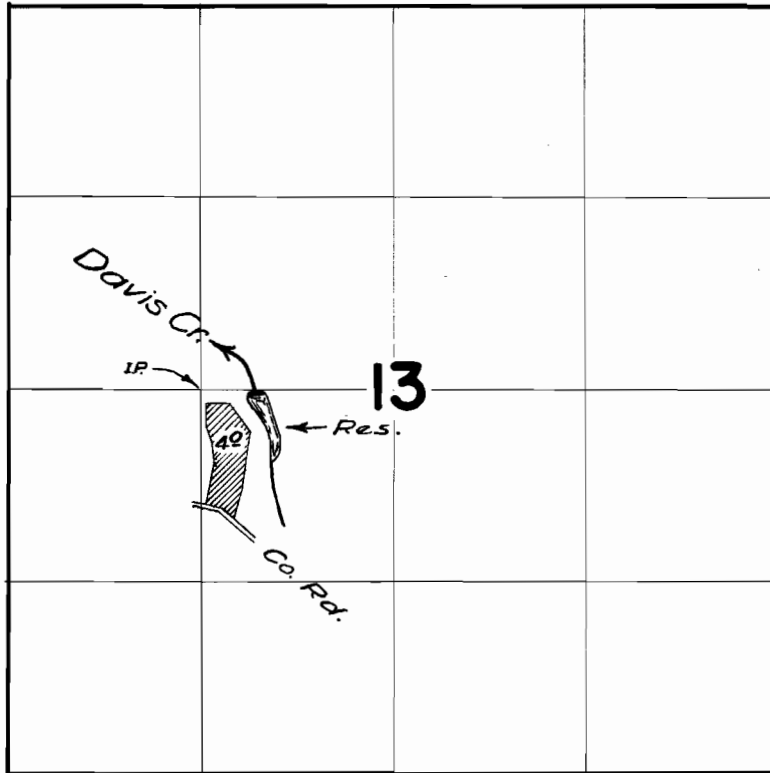

## FINAL PROOF SURVEY UNDER

Application No. R-29421 29115 Permit No. R-1656 23061  
IN NAME OF

Floyd L. Shortridge

Surveyed 22 April 1958, by m. Bish