


T.30S.R.15 W.W.M.

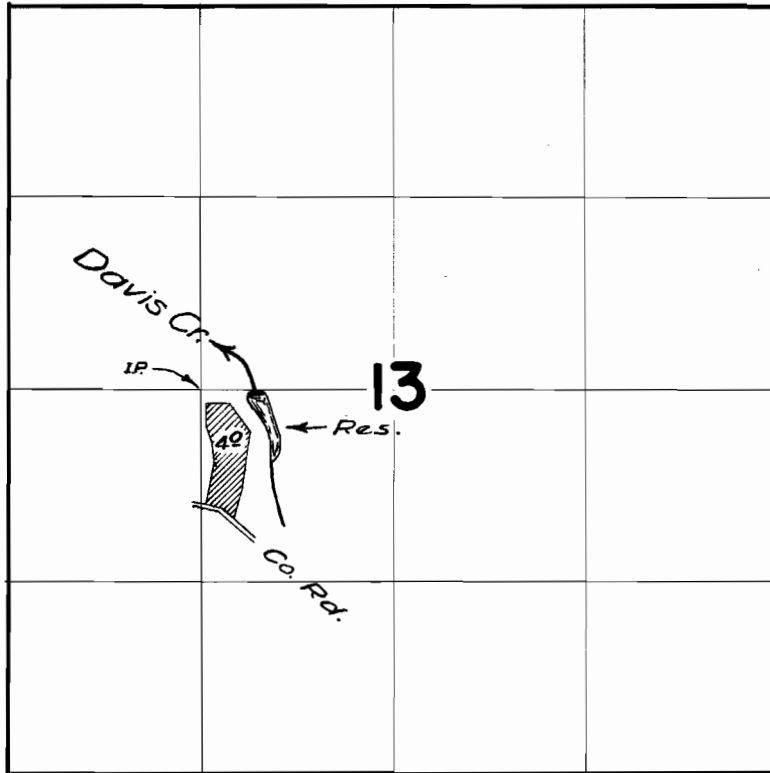

FINAL PROOF SURVEY UNDER

Application No. R-29421 29115 Permit No. R-1656 23061
IN NAME OF

Floyd L. Shortridge

Surveyed 22 April 1958, by m. Bish