


T.35S.R.14W.W.M.

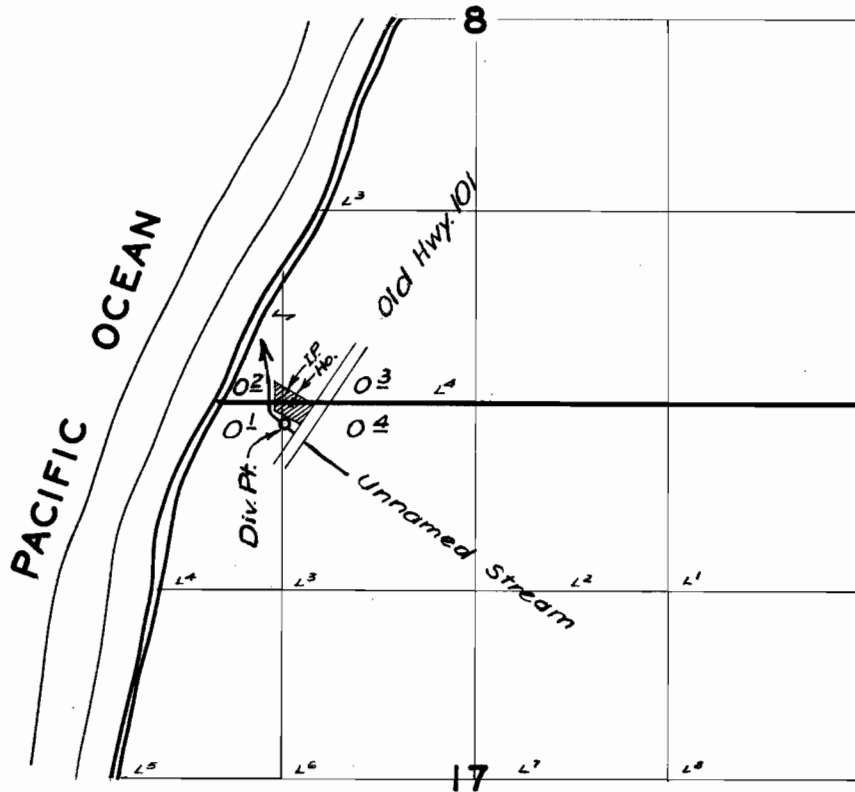

FINAL PROOF SURVEY
UNDER

Application No. 29259 Permit No. 23078
IN NAME OF

K. C. Barrington

Surveyed 17 April 1958, by M. Bish