


T.17S. R.9W.W.M.

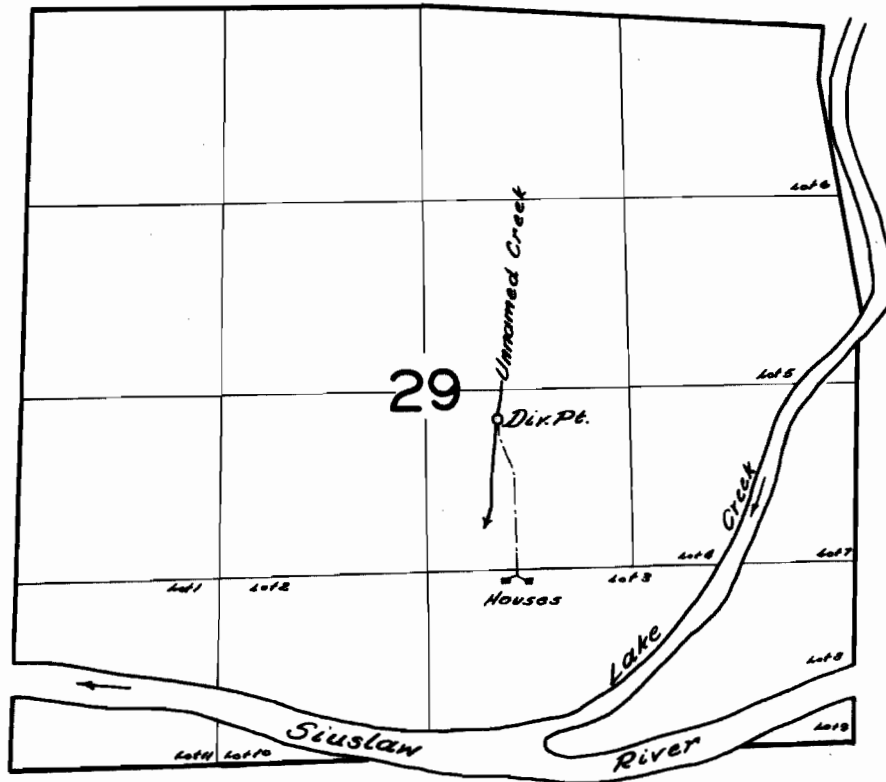

FINAL PROOF SURVEY
UNDER

Application No. 29389 Permit No. 23151
IN NAME OF

J.C. Addleman and John W. Tack

Surveyed May 15, 1957, by R.H. Wriekby