


T.7S. R.1E.W.M.

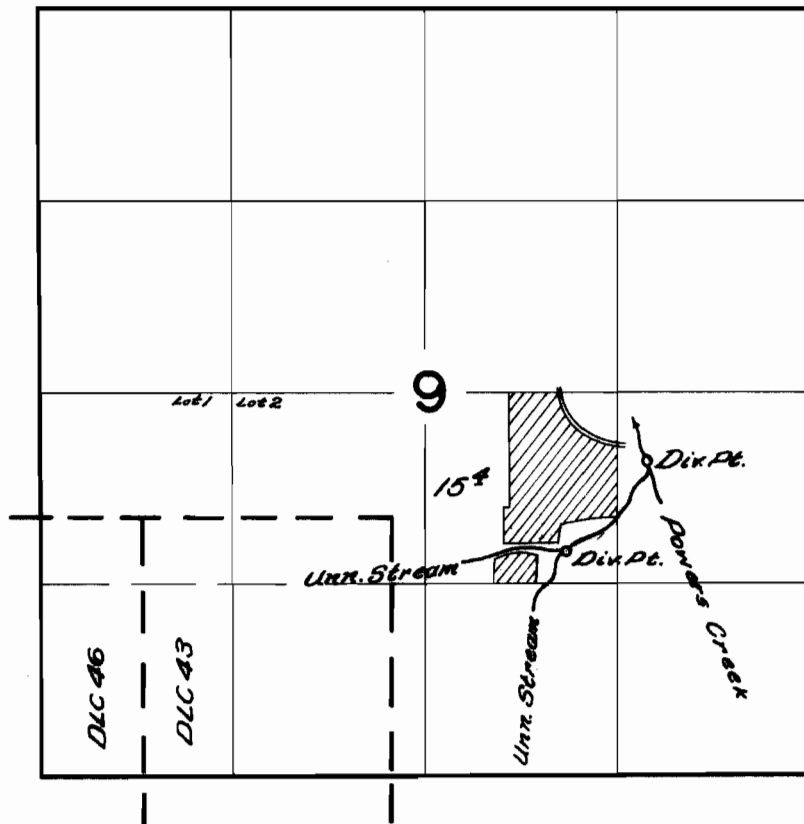

FINAL PROOF SURVEY
UNDER

Application No. *29568* Permit No. *23215*
IN NAME OF

M. E. Foote

Surveyed *May 14* 1958, by *C. D. Smith*