


T. 3S. R. 4E. W.M.

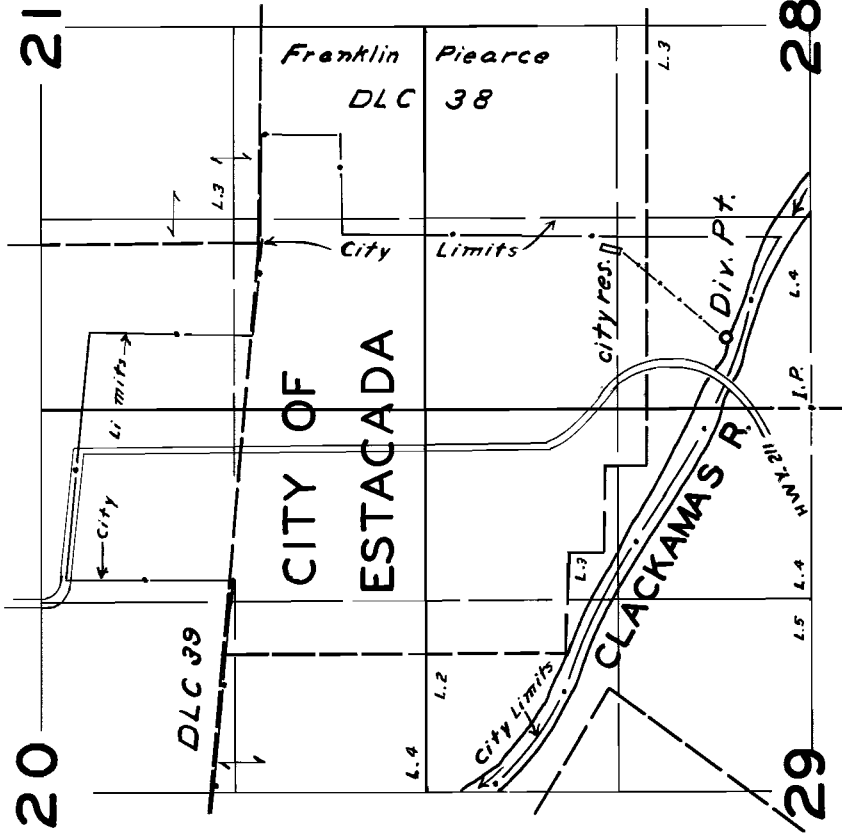

FINAL PROOF SURVEY UNDER

Application No. 29972 Permit No. 23610
IN NAME OF

City of Estacada

Surveyed Sept. 30 1958, by W.N. Perry

CITY LIMITS

T.3S., R.4 E.
SECTION CORNER
20 21
29 28

CITY LIMITS

1/4 Corner

1/4 Corner

CITY LIMITS

CLACKAMAS RIVER

W—E

SCALE 1"=200'



APPLICATION FILE NO. 29972 Permit No. 23610

CITY OF ESTACADA, ORE.

MAP OF AREA WITHIN WHICH WATER
IS TO BE USED FOR MUNICIPALITY

SCALE 1"=200'

DATE JUNE 14, 1955

FROM Old Maps

DESIGN. CLARK & GROFF ENGINEERS

3445 S. COMMERCIAL ST.

SALEM, OREGON

CHKD. H.C.

SHEET NO. 1 OF 1

Franklin

PIEARCE D.L.C.